


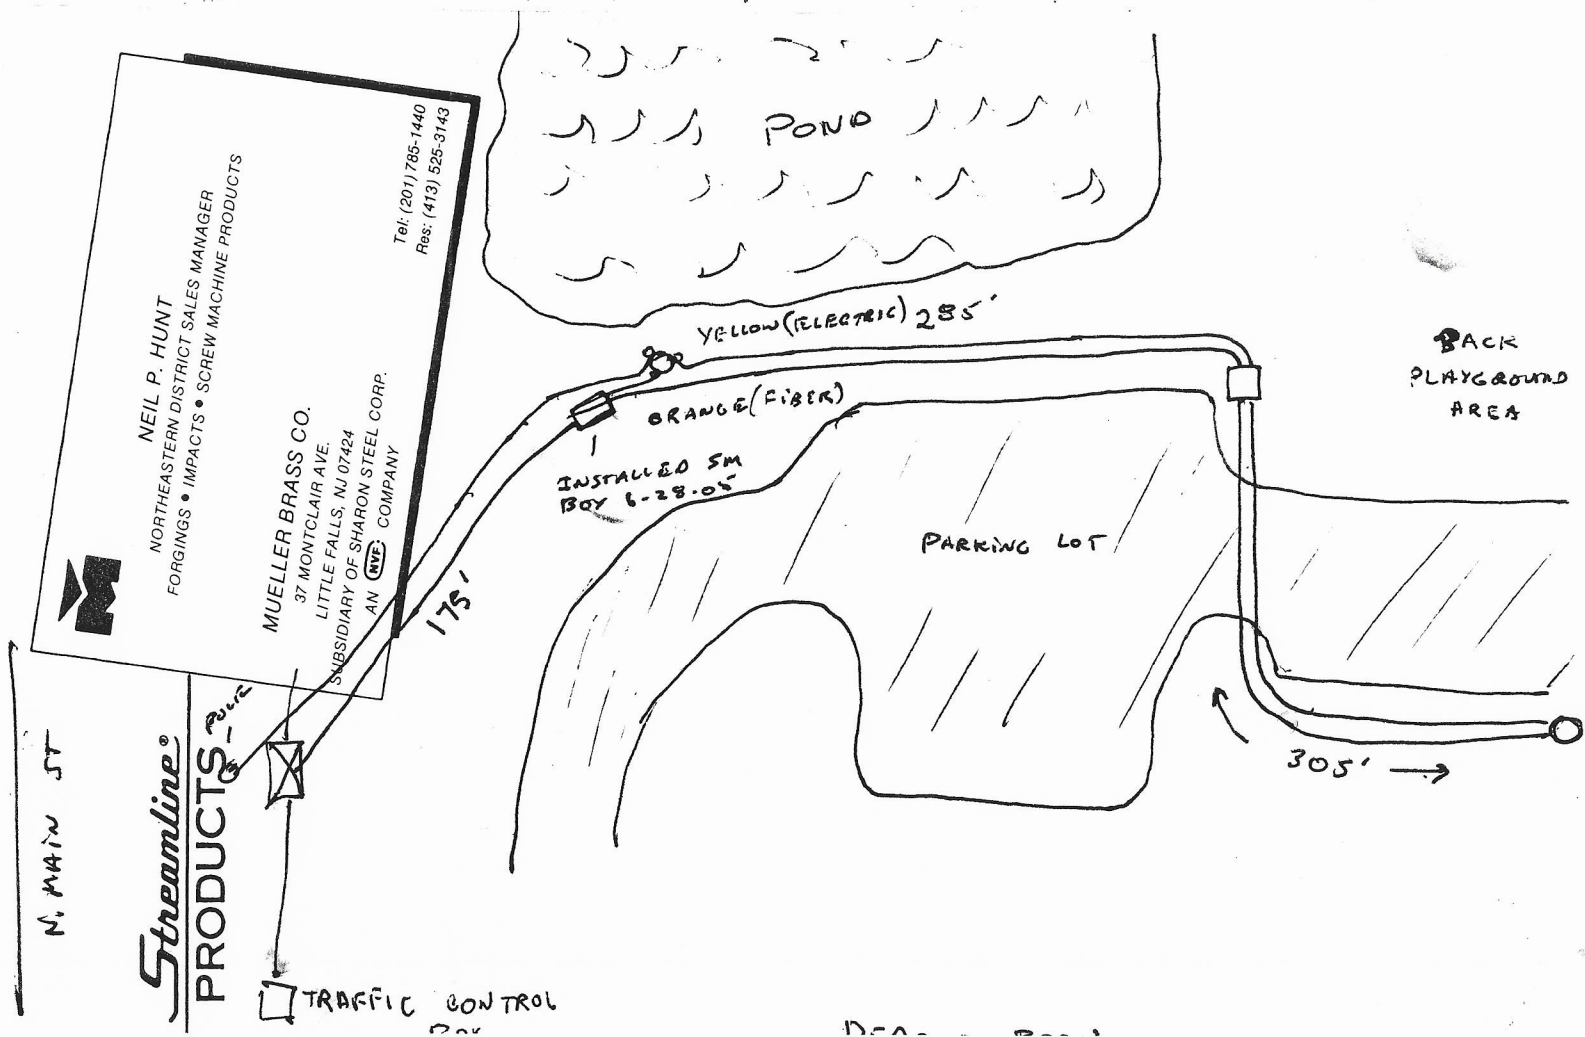

NEIL P. HUNT  
NORTHEASTERN DISTRICT SALES MANAGER  
FORGINGS • IMPACTS • SCREW MACHINE PRODUCTS

MUELLER BRASS CO.  
37 MONTCLAIR AVE.  
LITTLE FALLS, NJ 07424  
SUBSIDIARY OF SHARON STEEL CORP.  
AN  COMPANY

Tel: (201) 785-1440  
Res: (413) 525-3143





## Vellano Bros., Inc.


877-VELLANO (835-5266) [www.vellano.com](http://www.vellano.com)

Your Single Source for Pipe, Equipment, and Supplies for  
Underground Water, Sewer, and Drainage Systems

← N. MAIN ST →

HERITAGE PARK

N. MAIN  
DEARBORN

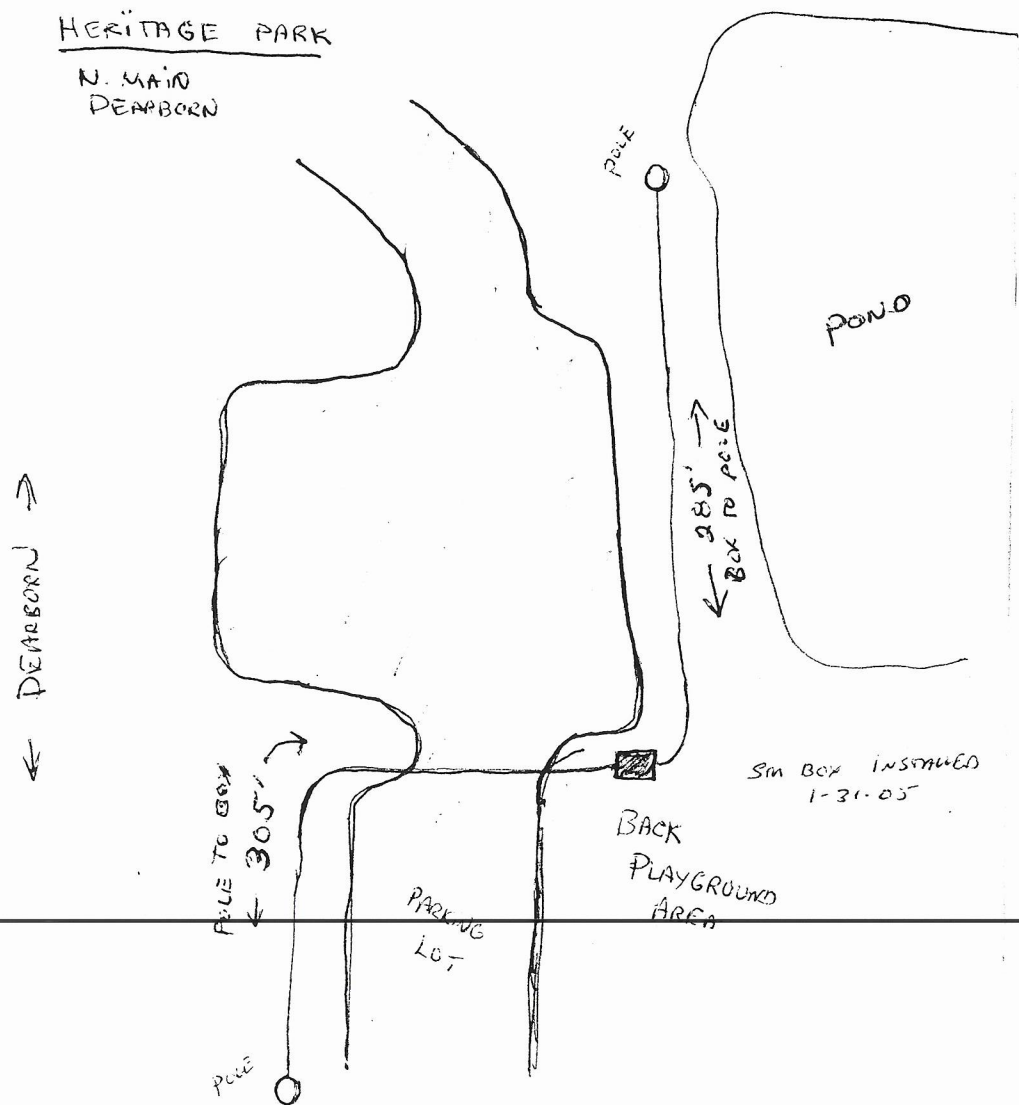

Water | Sewer | Municipal | Drainage