


CHESTNUT @ RAIL TRAIL

← TOWARD
INDUSTRIAL

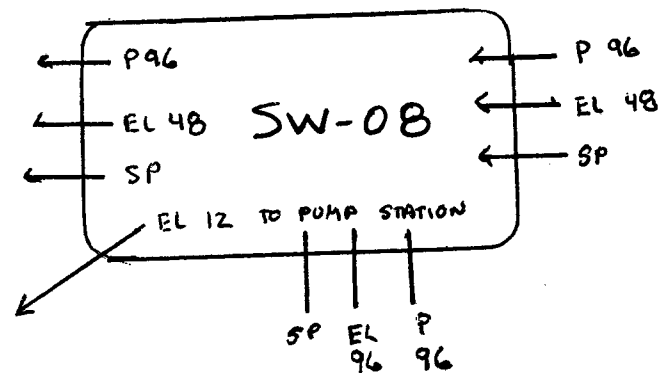

TOWARD
MAPLE →

NOT CONNECTED IN BOX
GOES TO PROSPECT WATER TOWER

↓
SHAKER RD