


Streamline[®]
PRODUCTS



PLEASANT ST

RANKIN TO
CENTER

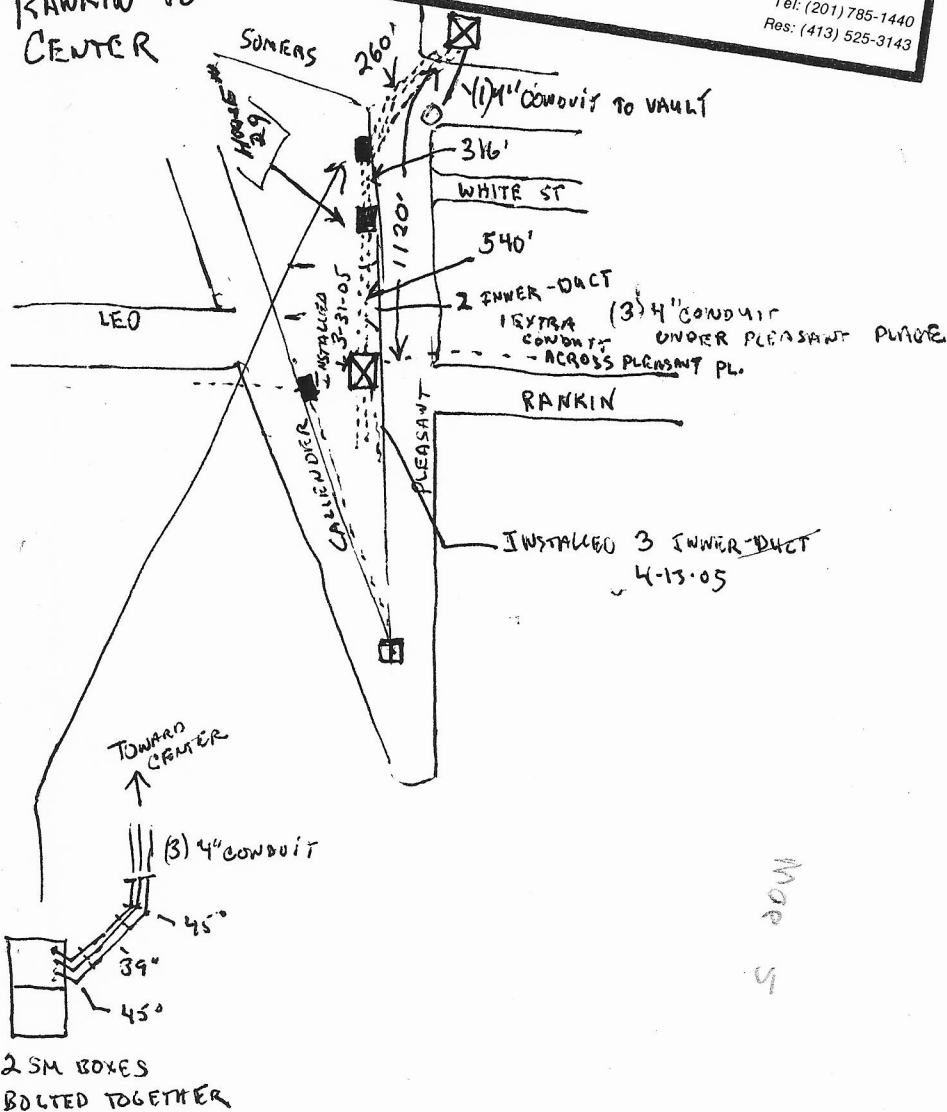

MOE
4