


**24 Hour
Emergency
Service**

TEAM **JPA**

Everett J. Prescott, Inc.

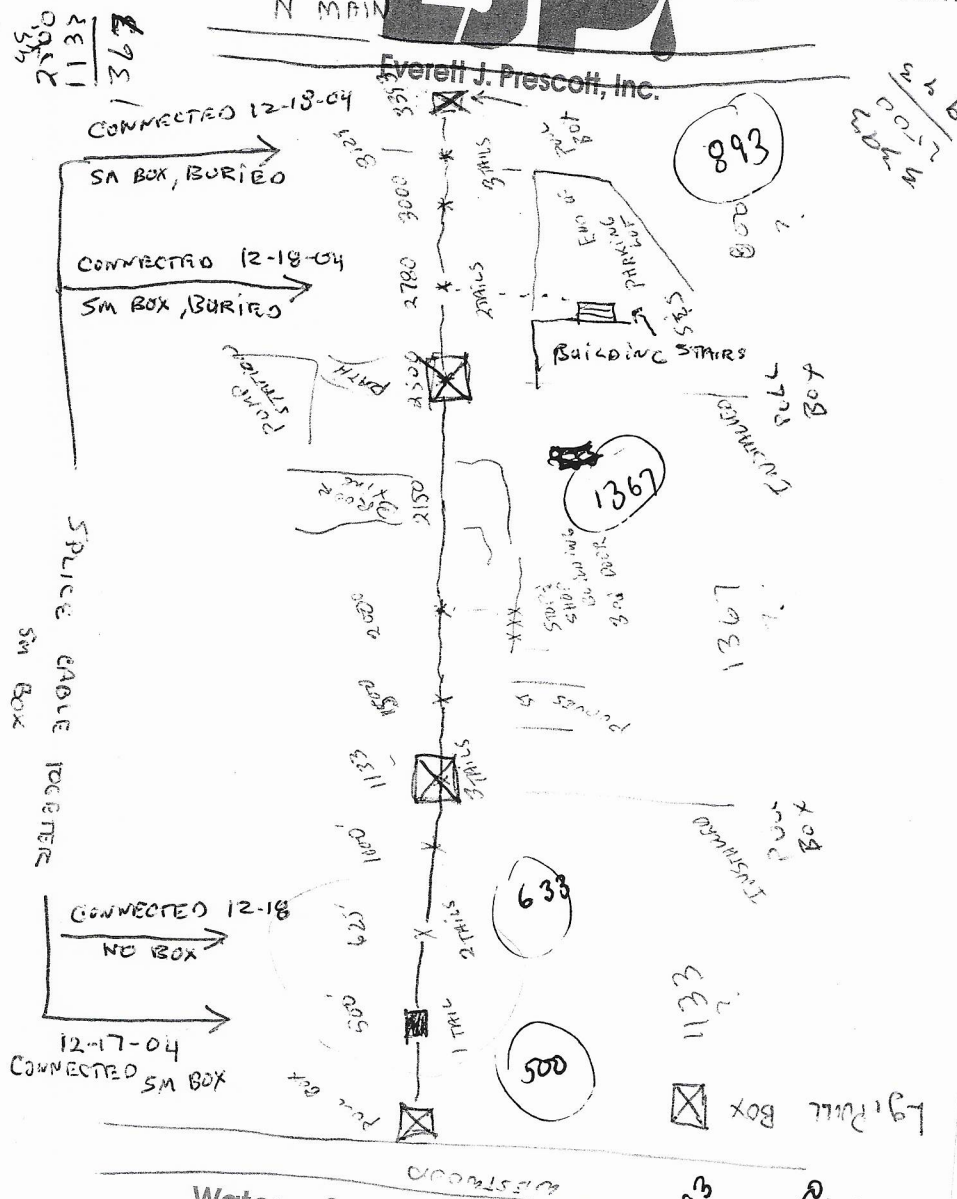

Water • Sewer • Drain • Gas

or your nearest EJP office call: **1-800-EJP-24HR**


www.ejprescott.com

e-mail: ejp@ejprescott.com

Pipeline Specialists

TEAM EJP

~~Everett J. Prescott, Inc.~~

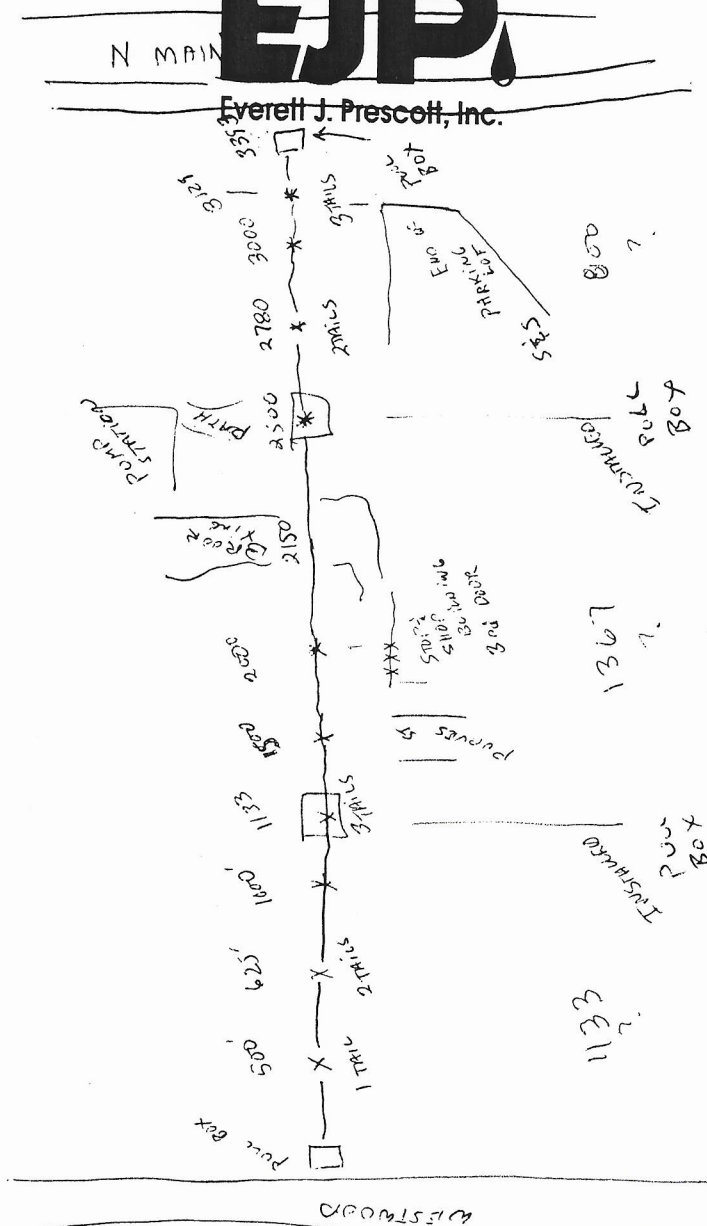

Water • Sewer • Drain • Gas

For your nearest EJP office call: 1-800-EJP-24HR

www.ejprescott.com


e-mail: ejp@ejprescott.com

e-mail: ejp@ejprescott.com

Serving
The Northeast &
Midwest



24 Hour
Emergency
Service

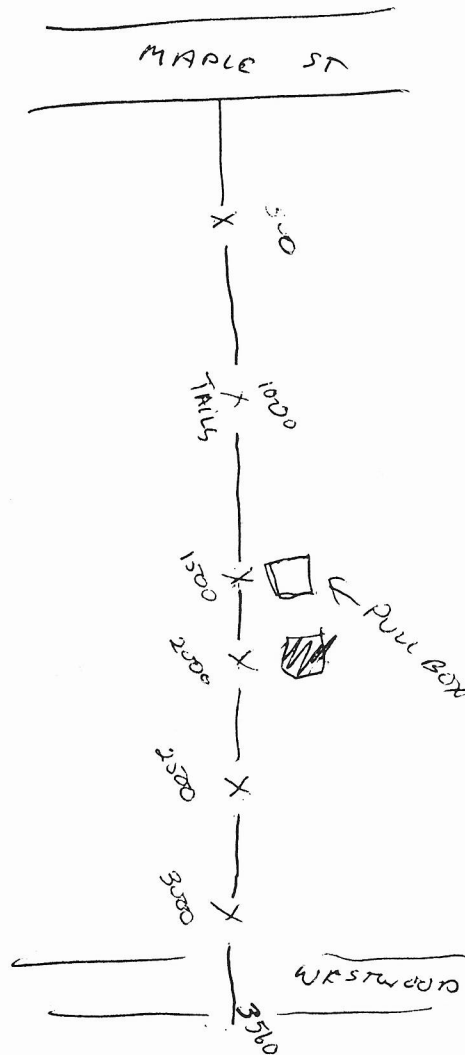

Water • Sewer • Drain • Gas

For your nearest EJP office call: **1-800-EJP-24HR**

www.ejprescott.com

e-mail: ejp@ejprescott.com


Serving
The Northeast &
Midwest

Pipeline Specialists

24 Hour
Emergency
Service



Everett J. Prescott, Inc.

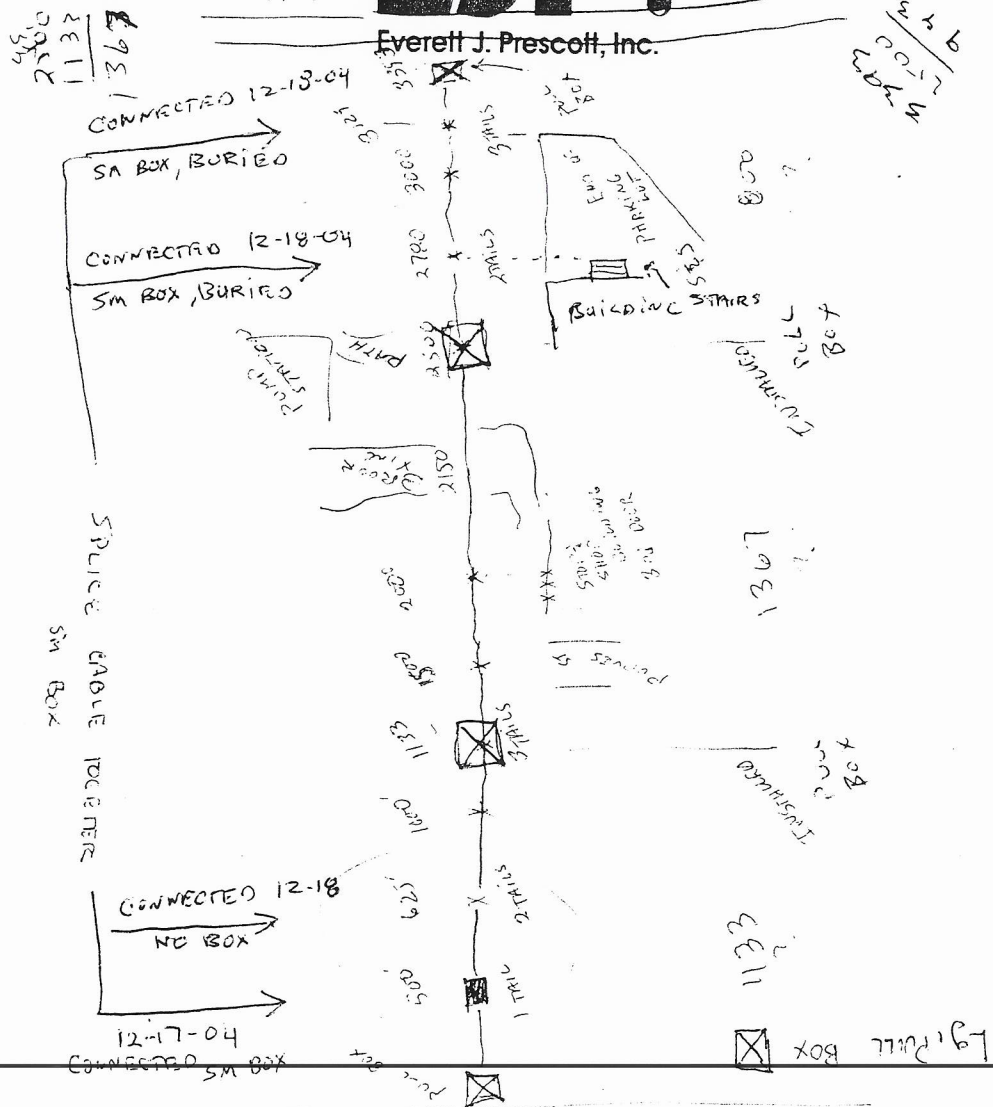

Water • Sewer • Drain • Gas

For your nearest EJP office call: 1-800-EJP-24HR

www.ejprescott.com


e-mail: eip@ejprescott.com

e-mail: eip@ejprescott.com

www.ejprescott.com

For your nearest EJP office call: 1-800-EJP-24HR

Water • Sewer • Drain • Gas

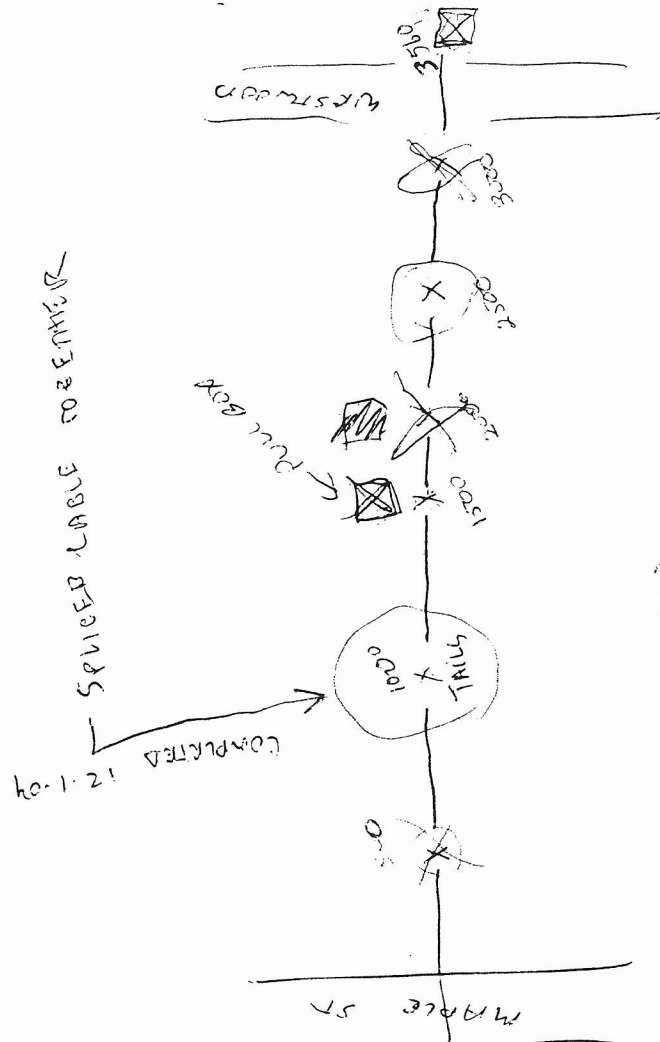

Everett J. Prescott, Inc.



Pipeline Specialists

24 Hour
Emergency
Service

Serving
The Northeast &
Midwest

**24 Hour
Emergency
Service**

TEAM EJP

Everett J. Prescott, Inc.

2480

Pumping Station

☒ Pull Box

SPlice cable together
Twist all 5m box

to
be
installed

CHESTNUT ST

NO BOXES

OPEN CABLE INNER MOST
3 TAILS 3' DEEP TO SCHOOL
CONNECTED
1-14-05
NO BOX

NEEDS TO
BE INSTALLED
TO SCHOOL
HIGH
(INSTALLED
2-05)
Kern
WIP

REPAIR

SVN BCK

PULL BOX INSTALLED

419 BROOK CROSSING

3 Tails

INSTALLED GREEN BOX
TAILS CONNECTED 12-10-64

SM 301 FORTIFIED

1000: Pull Box
3 TAILS INSTALLED
11-23

Lg Pull Box ☒
SM BOX ☐

pull Box 1925

MMPL E ST

~~Water • Sewer • Drain • Gas~~

For your nearest EJP office call: 1-800-EJP-24HR

www.ejprescott.com

e-mail: ejp@ejprescott.com

5244 INDUSTRIAL
TO MARLE

Serving
The Northeast &
Midwest


Pipeline Specialists



Everett J. Prescott, Inc.

24 Hour
Emergency
Service

1886 TOTAL

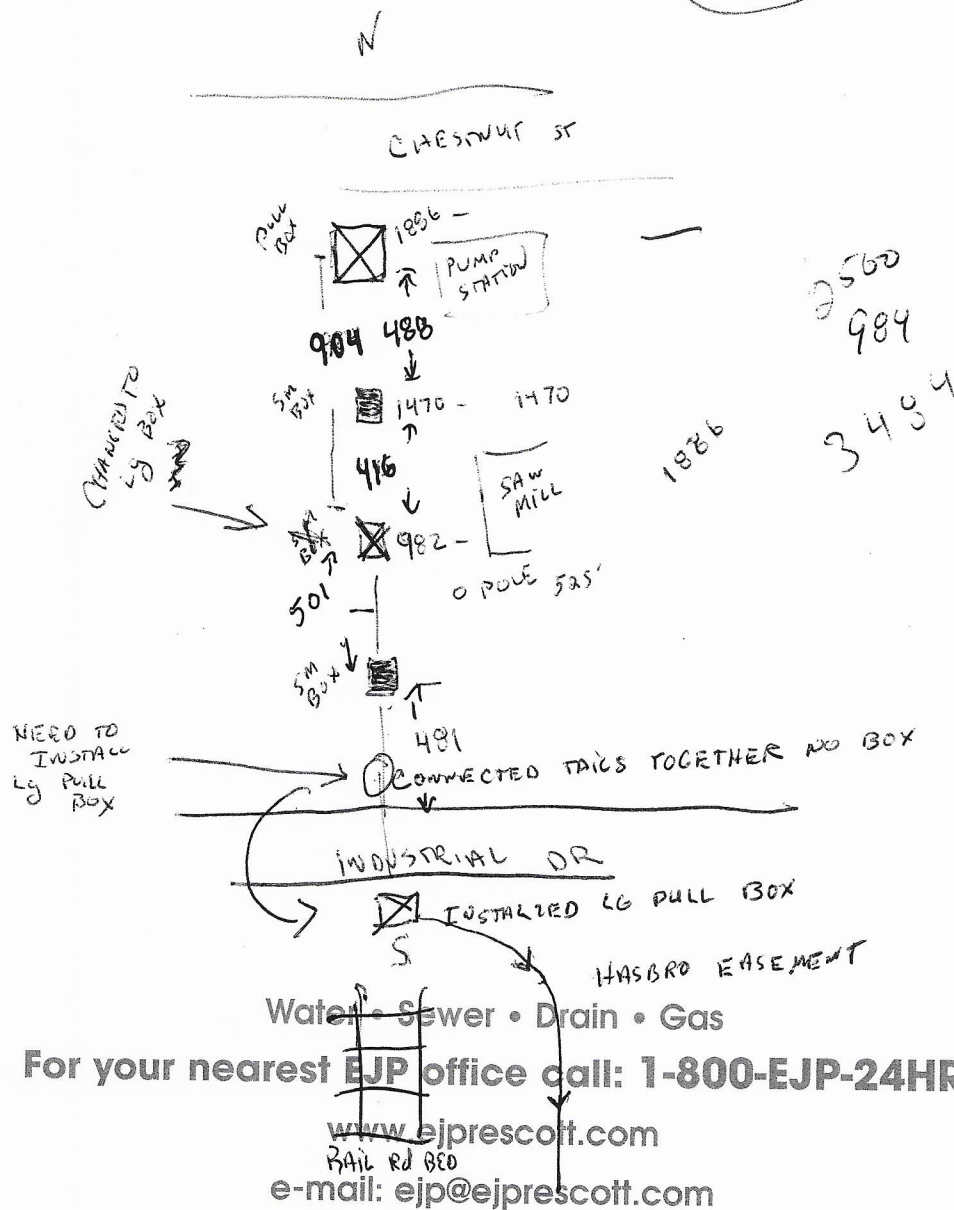

Water • Sewer • Drain • Gas

For your nearest EJP office call: 1-800-EJP-24HR

www.ejprescott.com

e-mail: ejp@ejprescott.com



Vellano Bros., Inc.


877-VELLANO (835-5266) www.vellano.com

Your Single Source for Pipe, Equipment, and Supplies for
Underground Water, Sewer, and Drainage Systems

(2)

X CONNECTED TAILS NO BOX

INDUSTRIAL DR

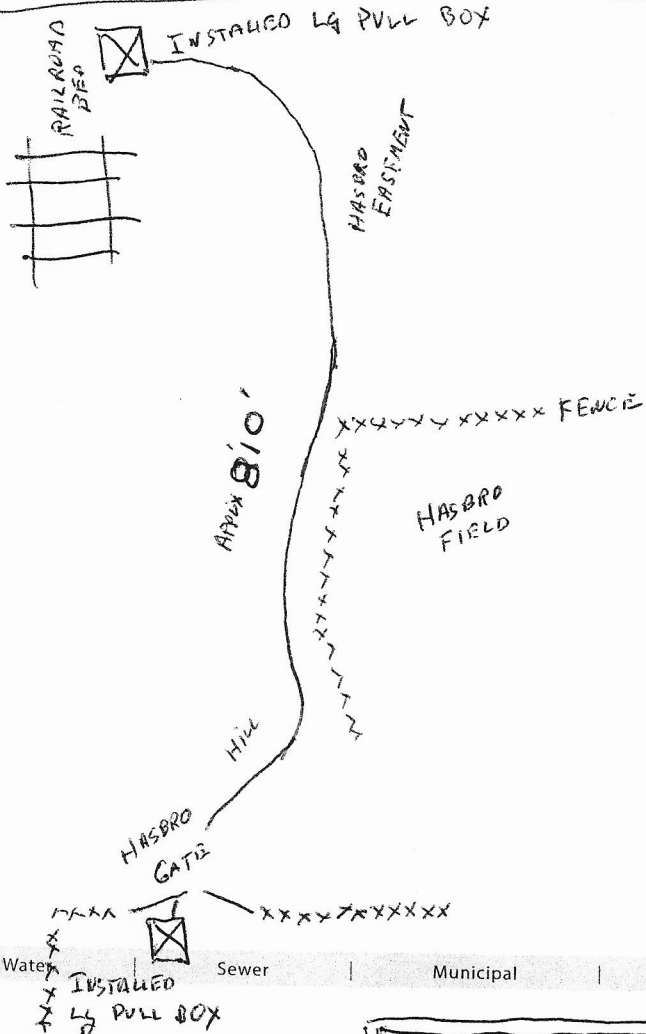




Vellano Bros., Inc.

877-VELLANO (835-5266) www.vellano.com

Your Single Source for Pipe, Equipment, and Supplies for
Underground Water, Sewer, and Drainage Systems

①

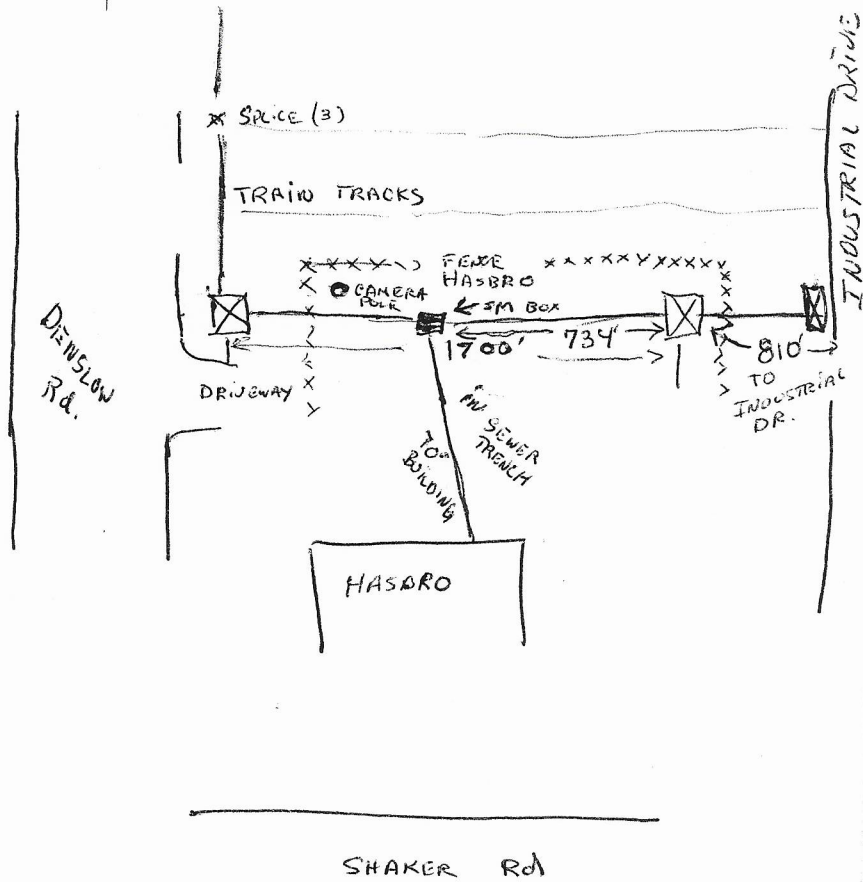

Water

Sewer

Municipal

Drainage