



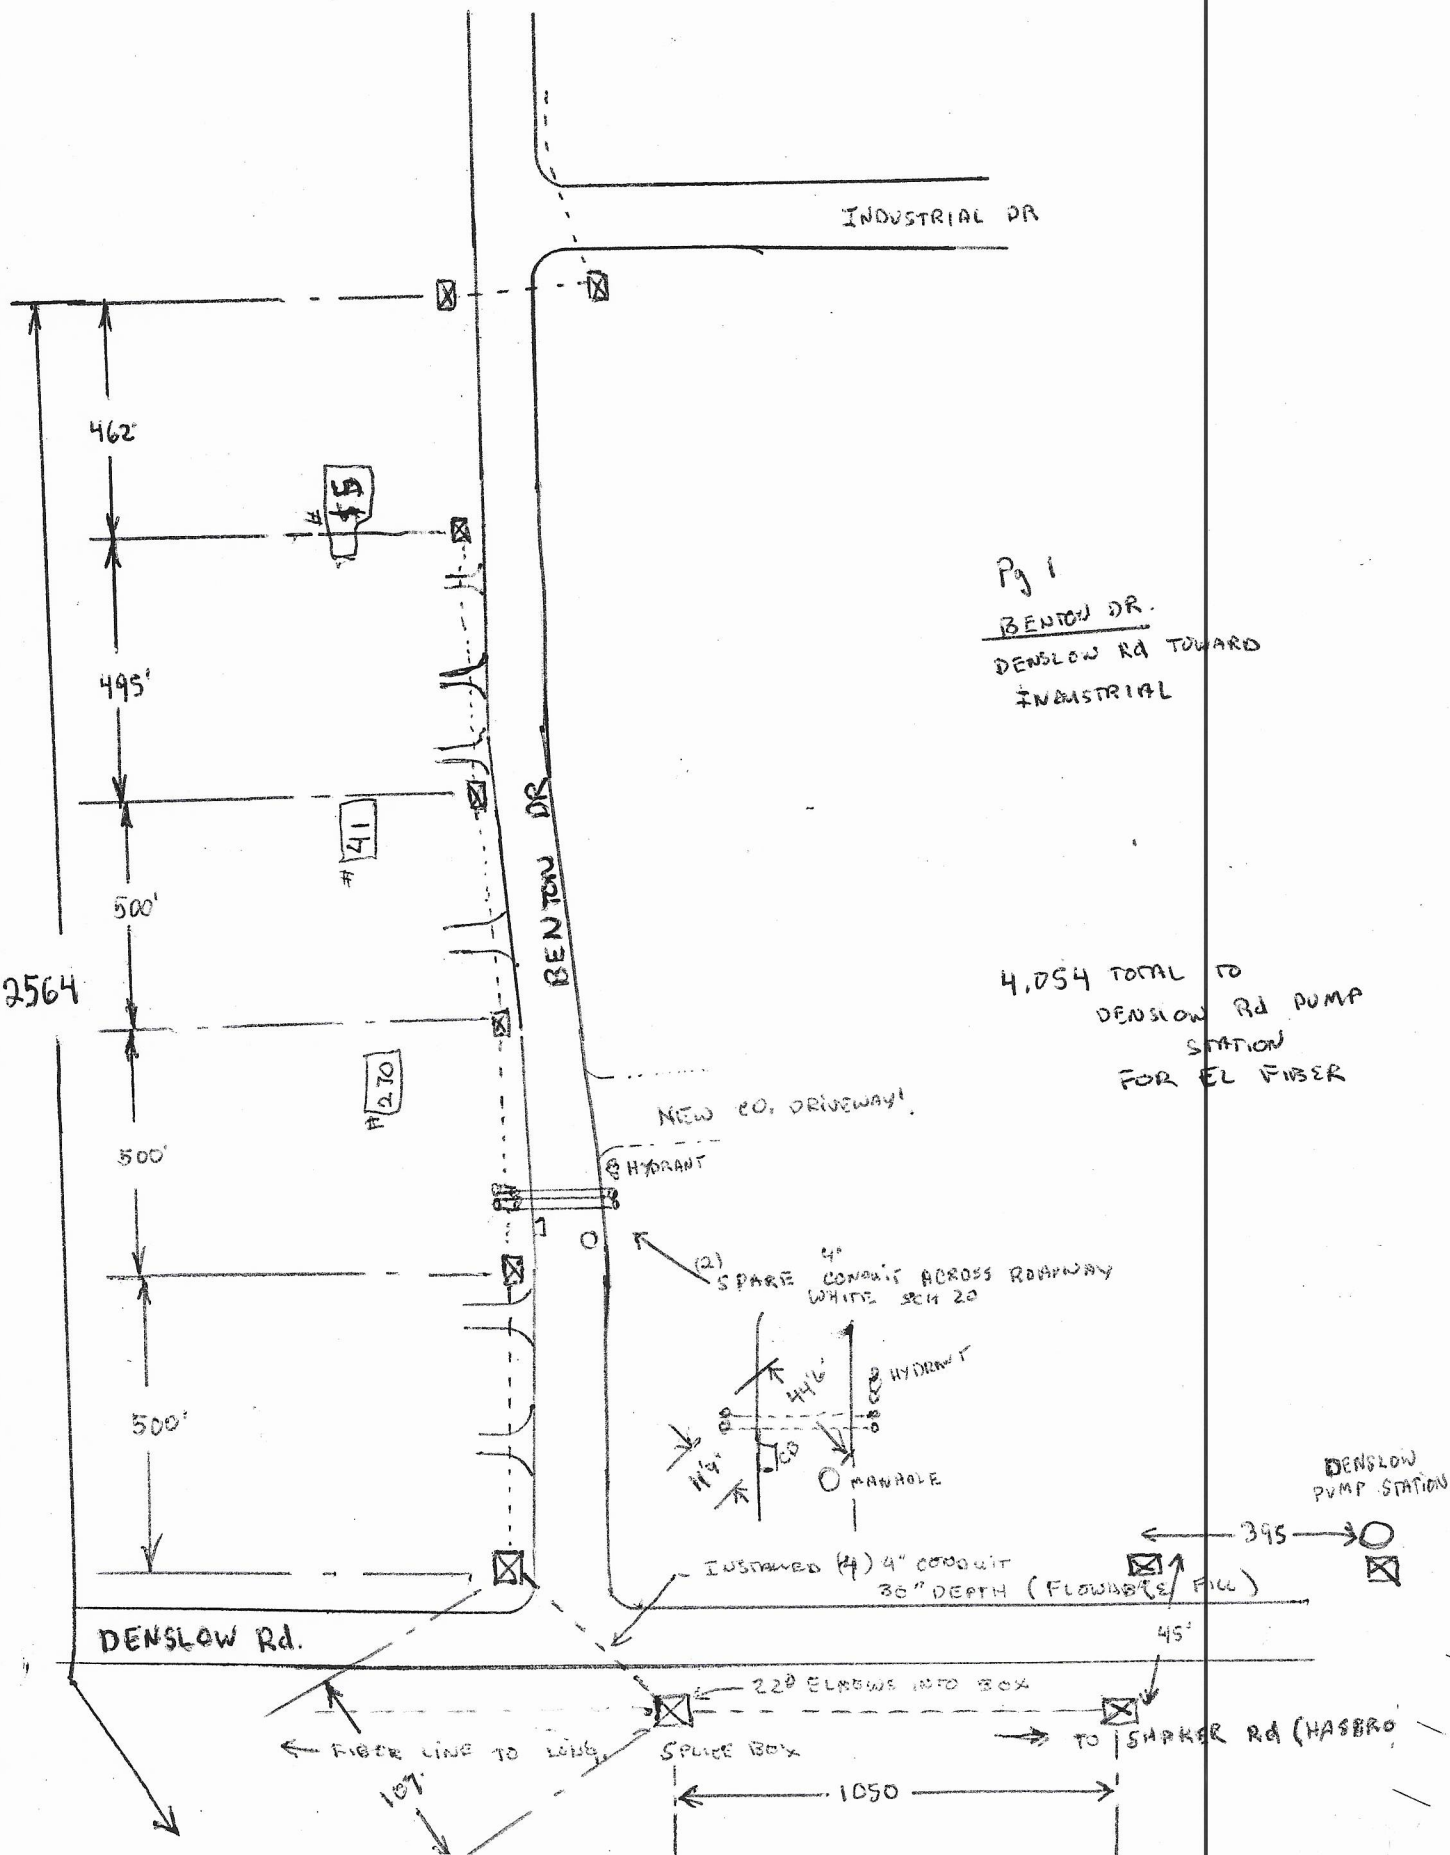

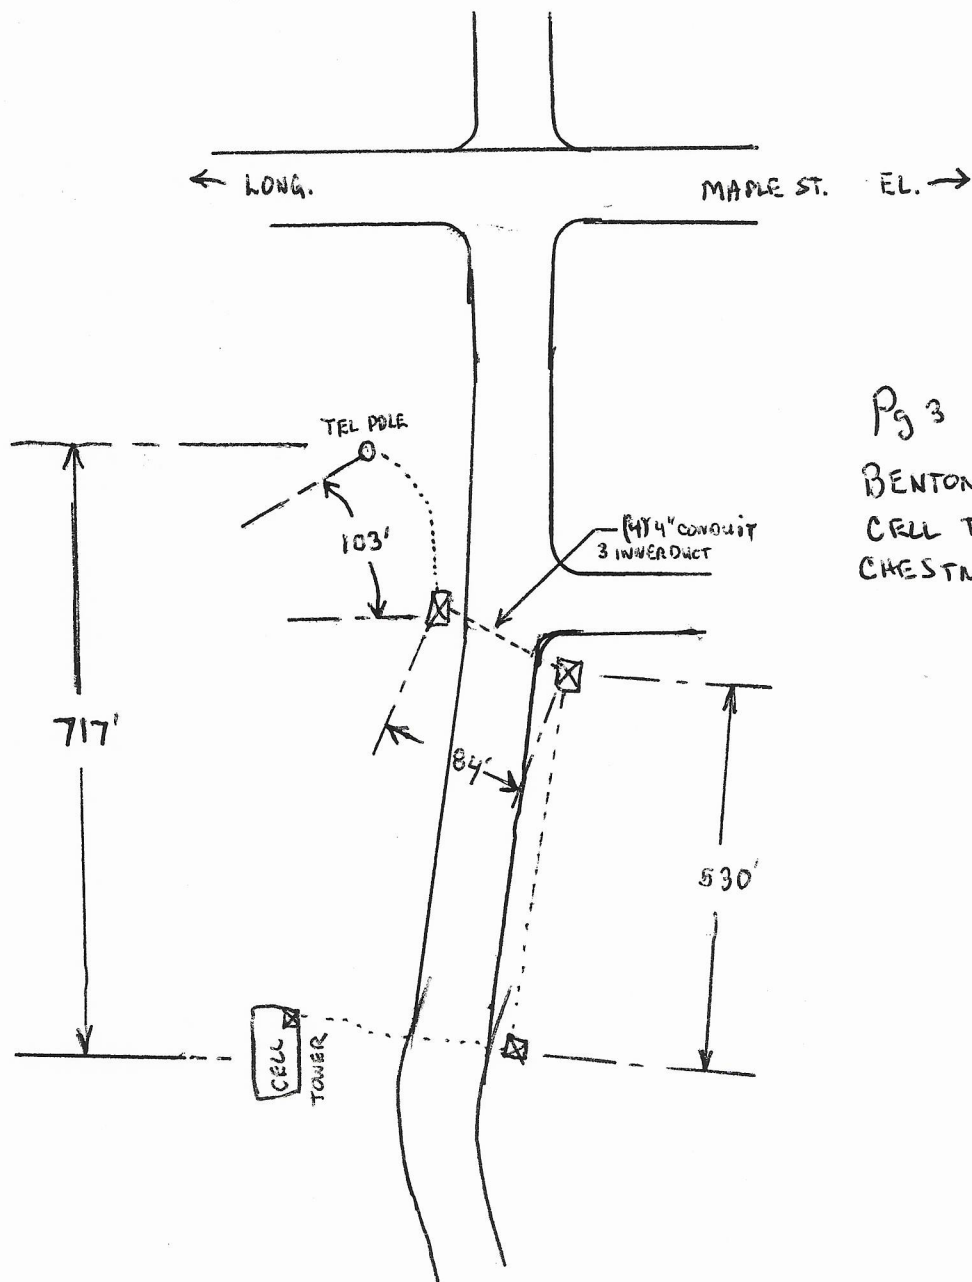

Pg 3
BENTON DR
CELL TOWER TO
CHESTNUT ST