


Streamline[®]
PRODUCTS

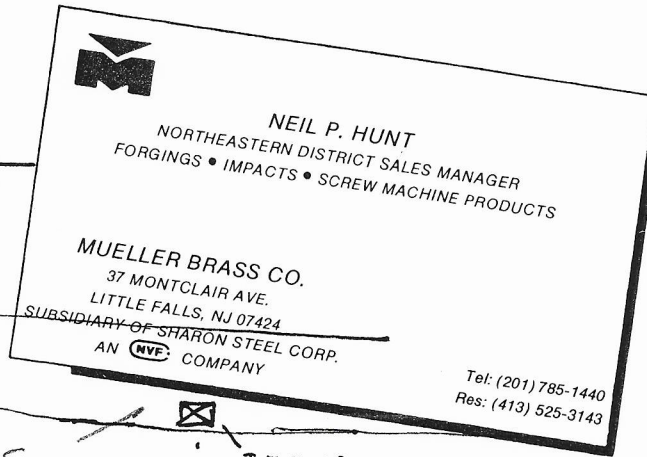

HANWARD
HILL

SEE MAP 3

300'

INSTALLED
3-17-05

(2) 4" CONDUIT END 10' OFF
BERM

ELMCREST

INSTALLED
3-16-05

164'

PULL BOX

BIRCHLAND
SCHOOL

MAP 2


SEE
MAP 1



Vellano Bros., Inc.

877-VELLANO (835-5266) www.vellano.com

Your Single Source for Pipe, Equipment, and Supplies for
Underground Water, Sewer, and Drainage Systems

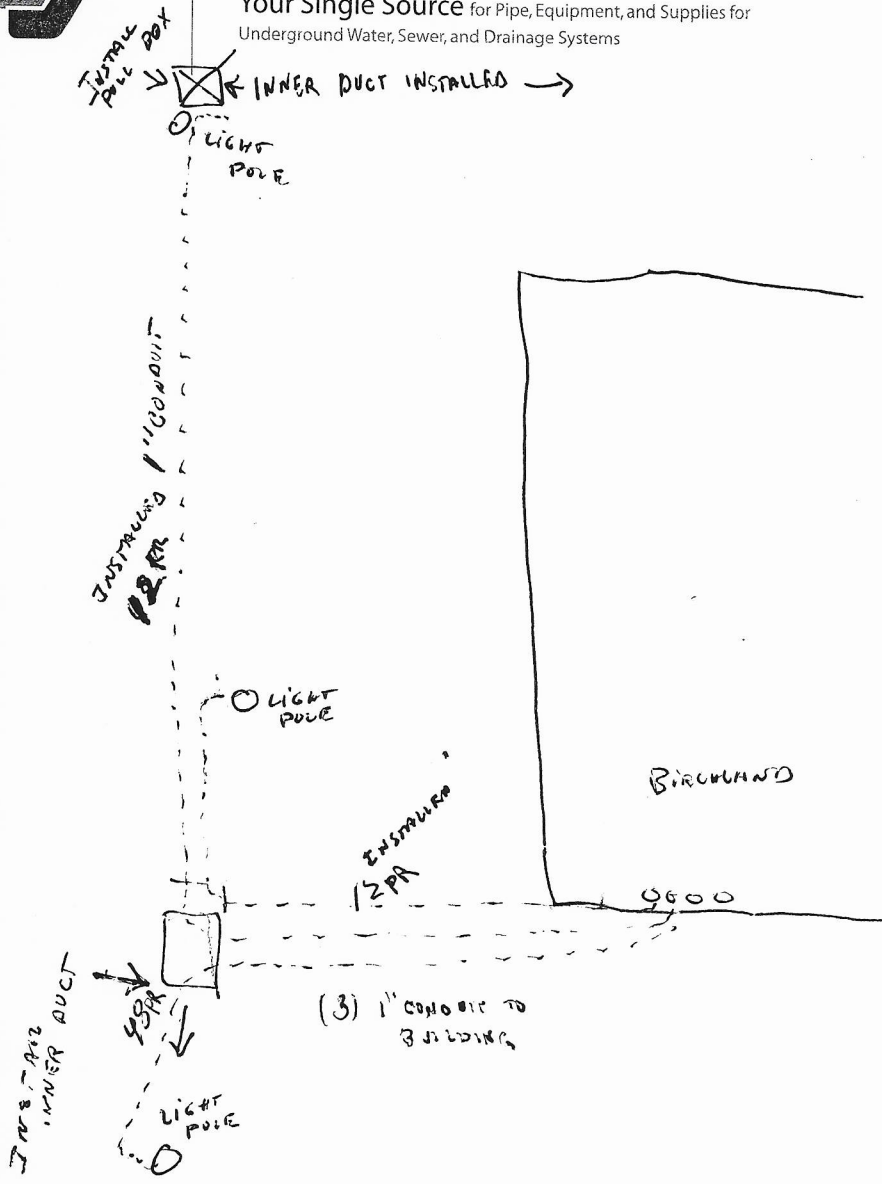

Water

Sewer

Municipal


Drainage



Vellano Bros., Inc.

877-VELLANO (835-5266) www.vellano.com

Your Single Source for Pipe, Equipment, and Supplies for
Underground Water, Sewer, and Drainage Systems

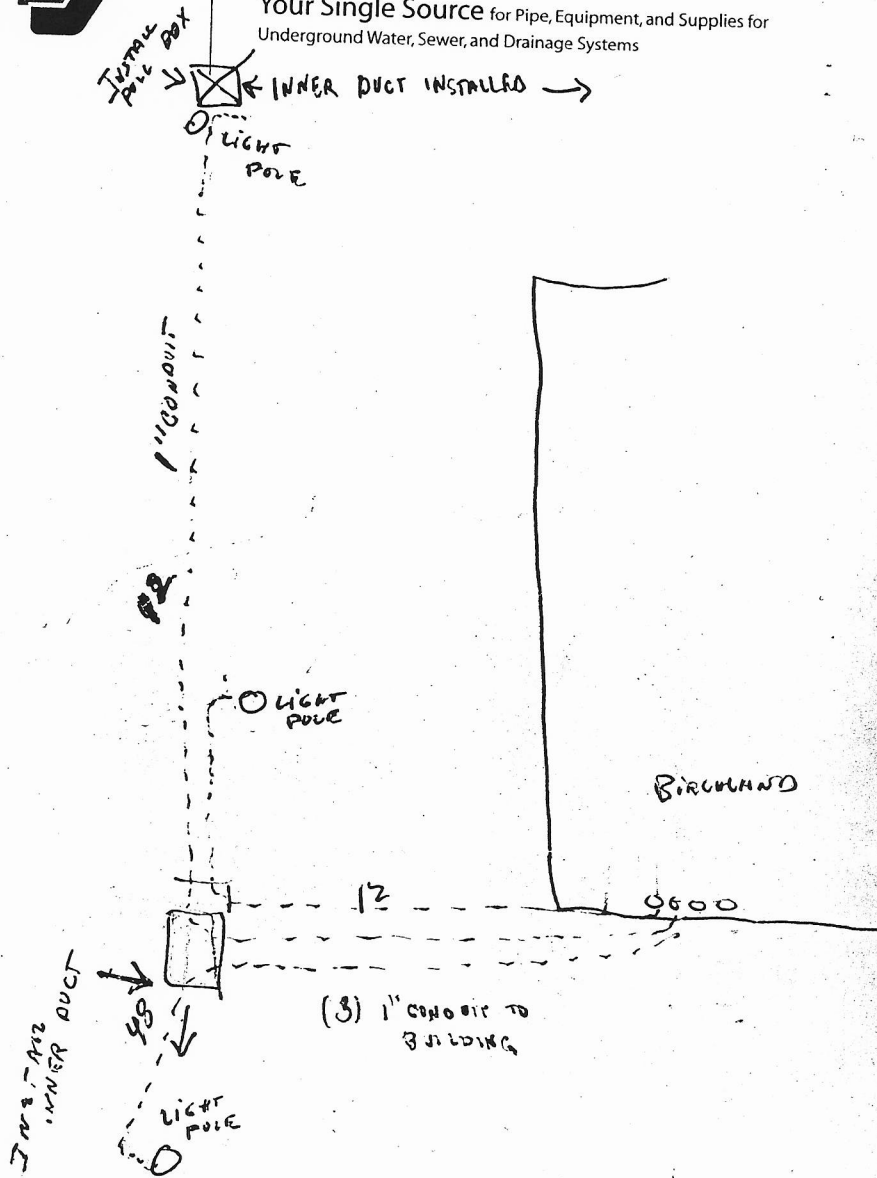

Water

Sewer

Municipal

Drainage


Streamline[®]
PRODUCTS



NEIL P. HUNT
NORTHEASTERN DISTRICT SALES MANAGER
FORGINGS • IMPACTS • SCREW MACHINE PRODUCTS

MUELLER BRASS CO.
37 MONTCLAIR AVE.
LITTLE FALLS, NJ 07424
SUBSIDIARY OF SHARON STEEL CORP.
AN **NVF** COMPANY

Tel: (201) 785-1440
Res: (413) 525-3143

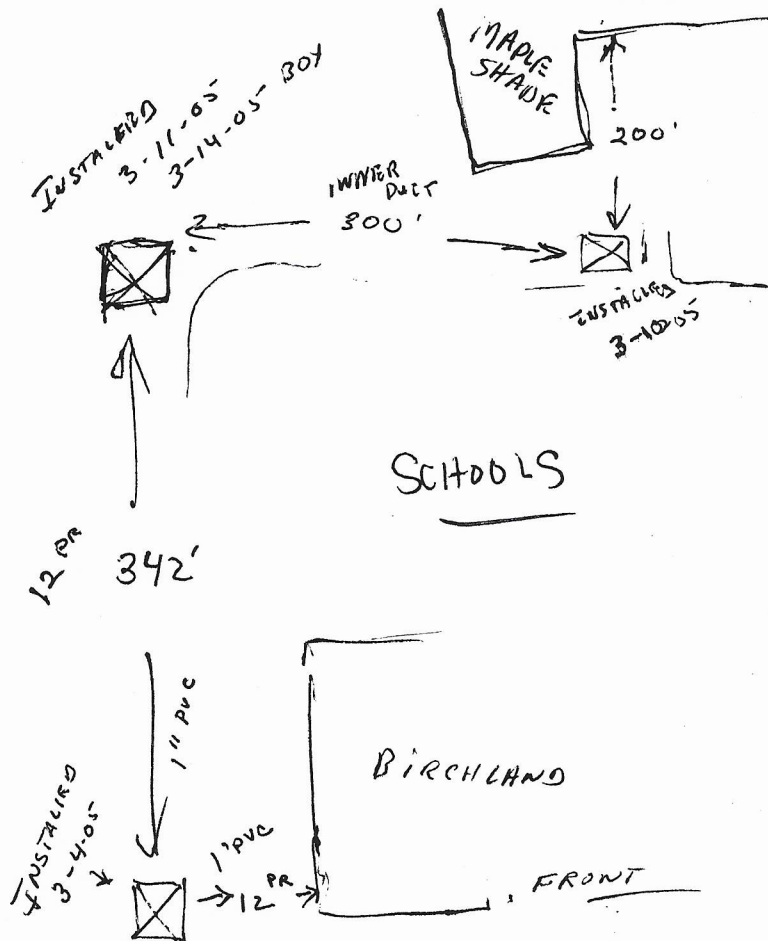

MAP 1