


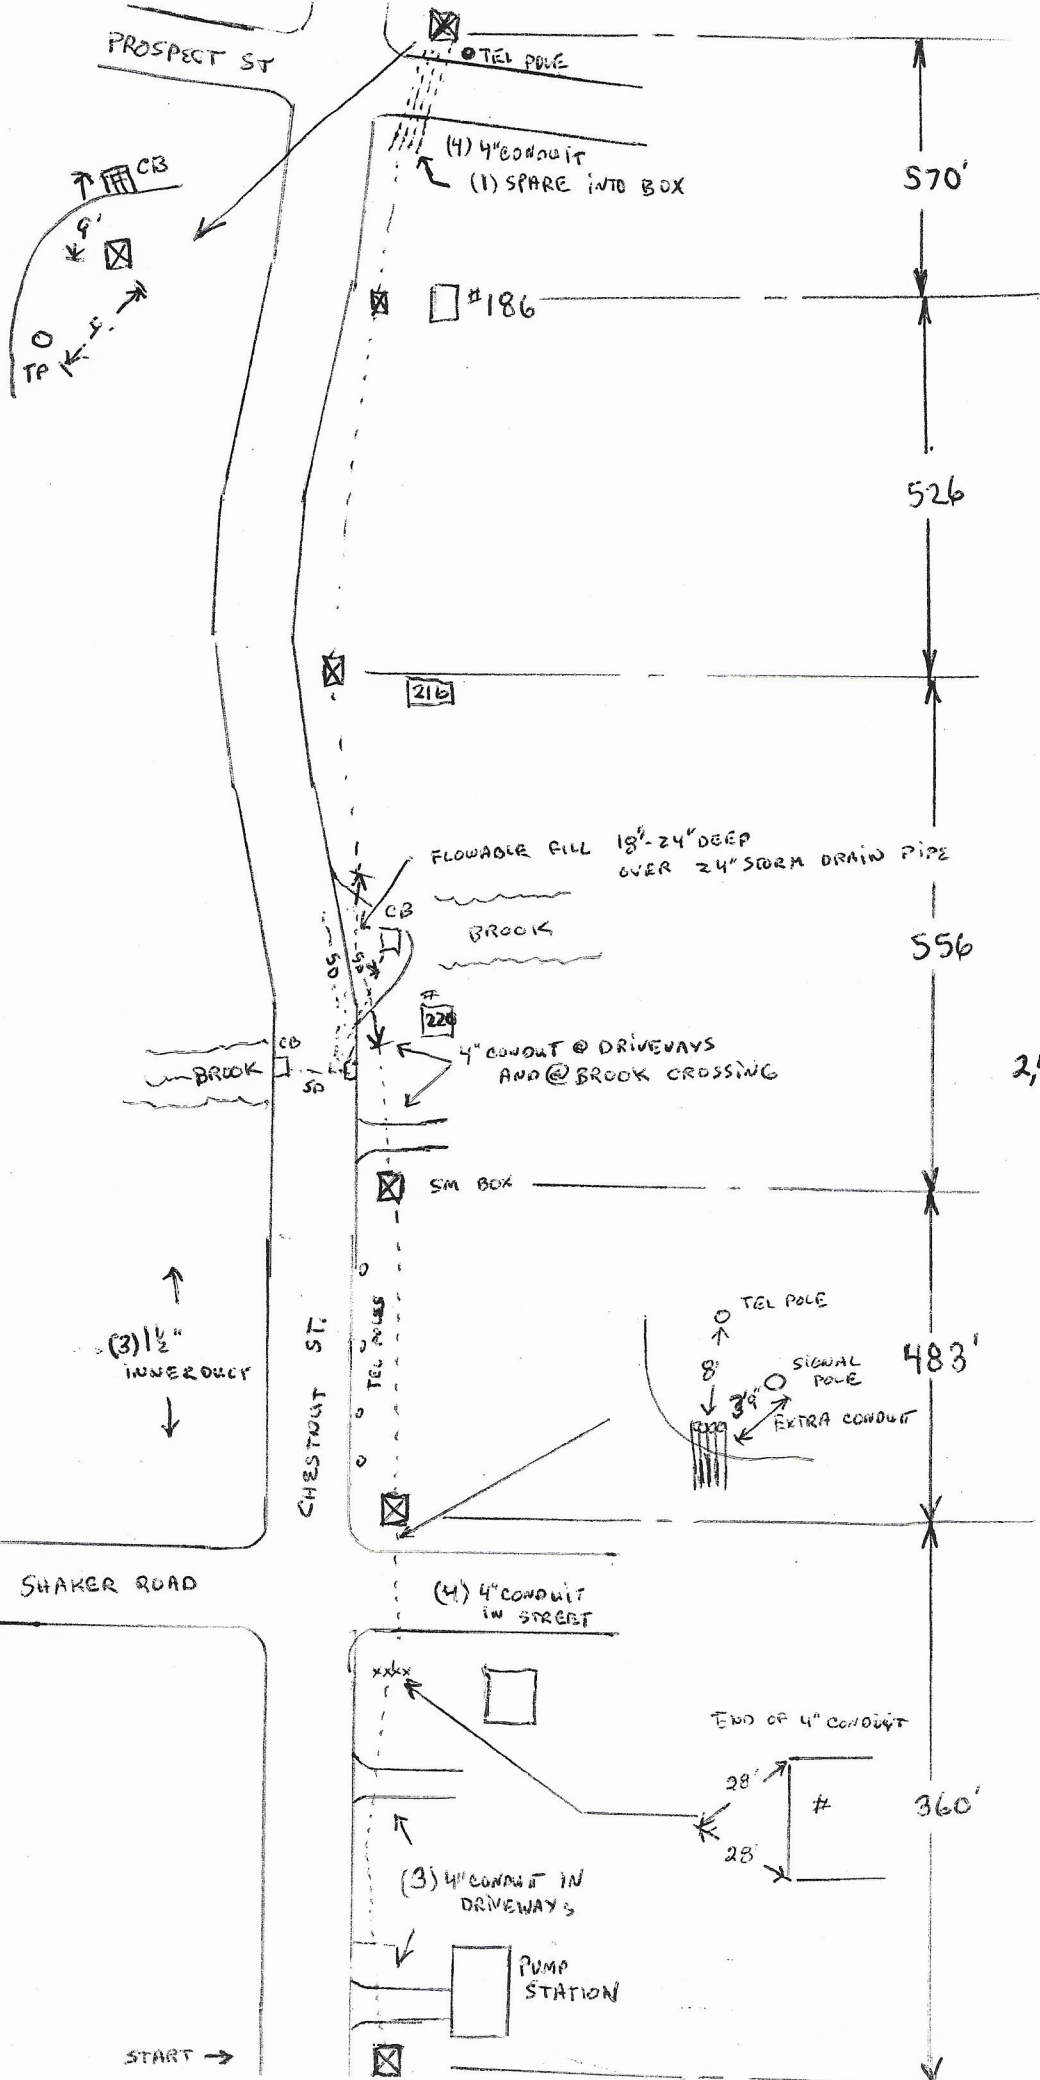

Pg. 1

CHESTNUT ST

PUMP STATION
TO PROSPECT ST

2,495

570'

526

556

483'

360'

PROSPECT ST

TEL POLE

(4) 4" CONDUIT
(1) SPARE INTO BOX

#186

216

FLOWABLE FILL 18"-24" DEEP
OVER 24" STORM DRAIN PIPE

BROOK

#220

4" CONDUIT @ DRIVEWAYS
AND @ BROOK CROSSING

SM BOX

TEL POLE

SIGNAL POLE

EXTRA CONDUIT

CHESTNUT ST

SHAKER ROAD

(4) 4" CONDUIT
IN STREET


END OF 4" CONDUIT

(3) 4" CONDUIT IN
DRIVEWAYS

PUMP
STATION



START →

(3) 1 1/2" INNEEDUCT

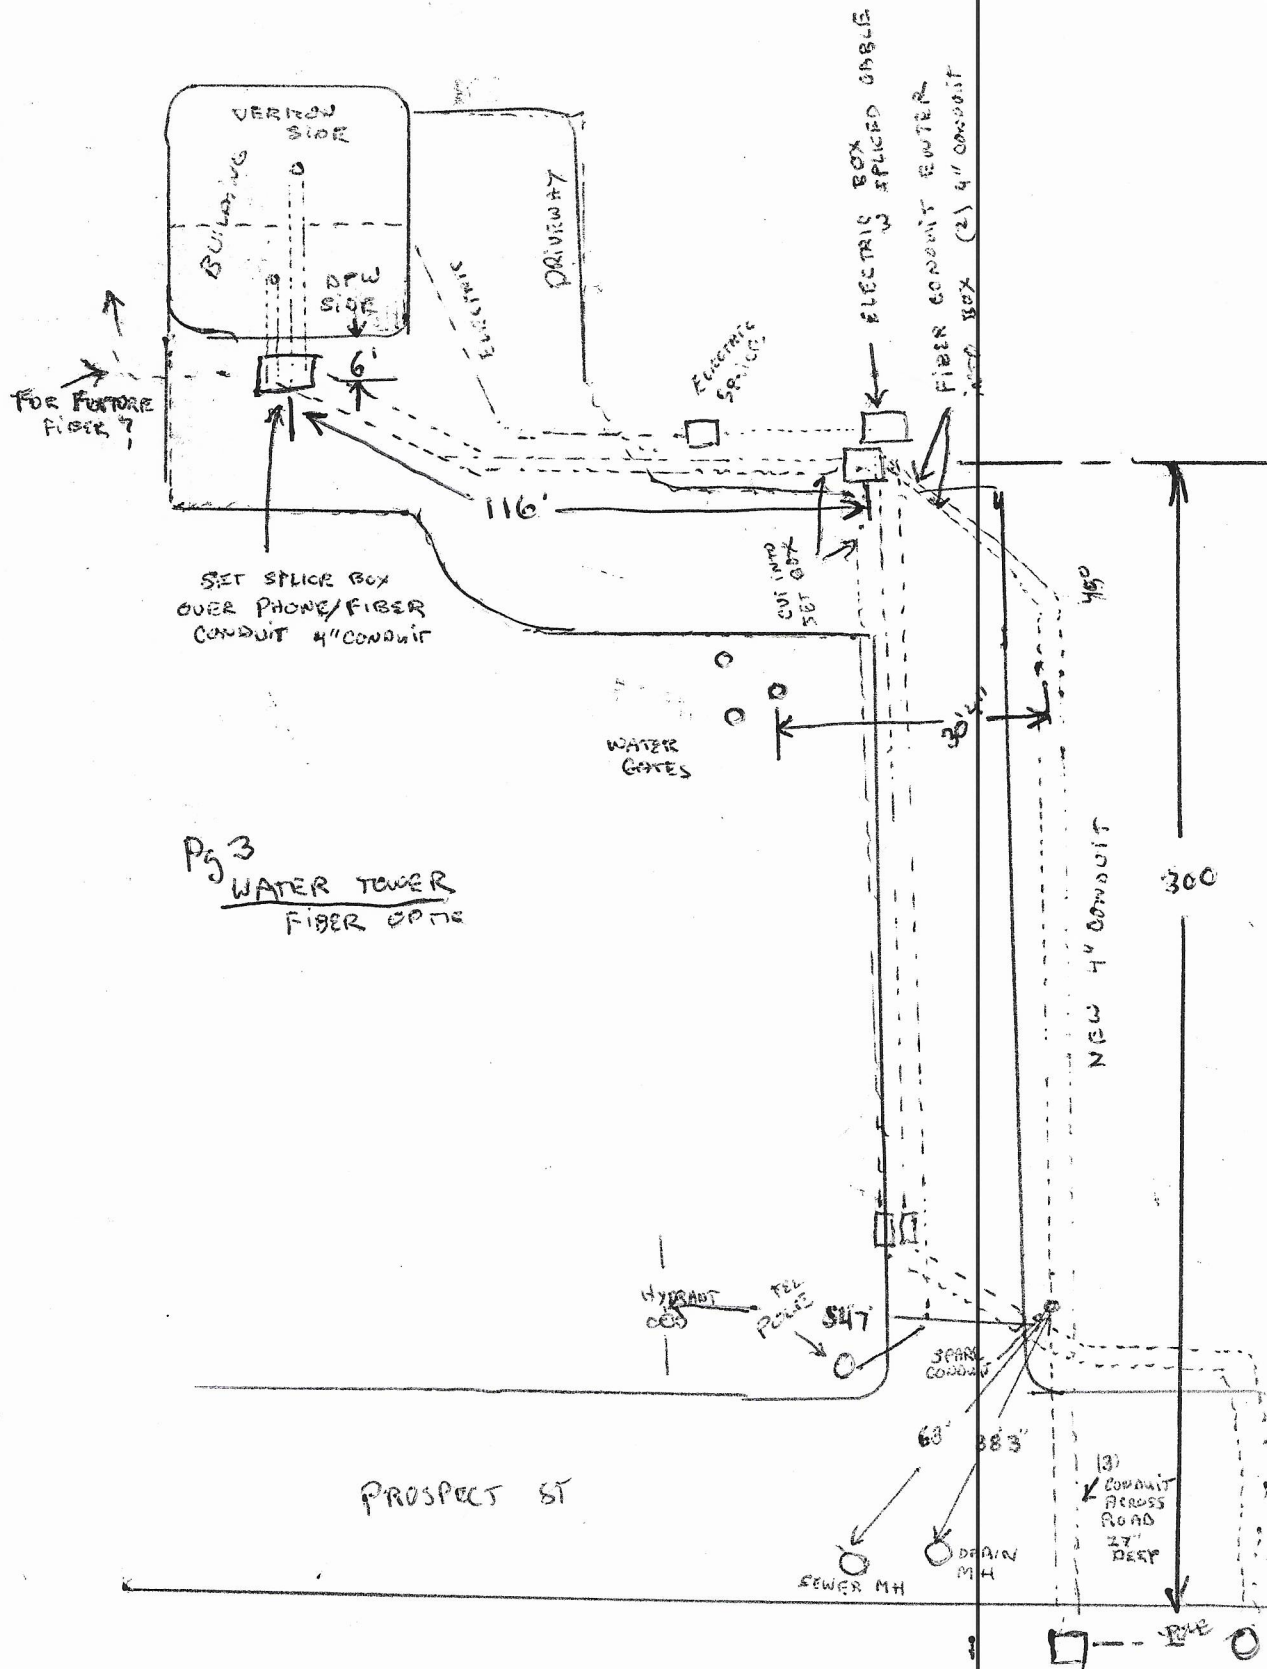

Pg 3
 WATER TOWER
 FIBER OPTIC

Streamline[®]
PRODUCTS

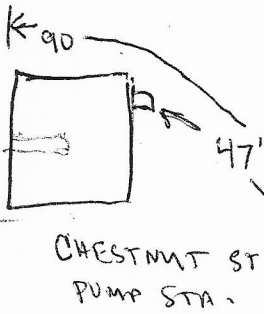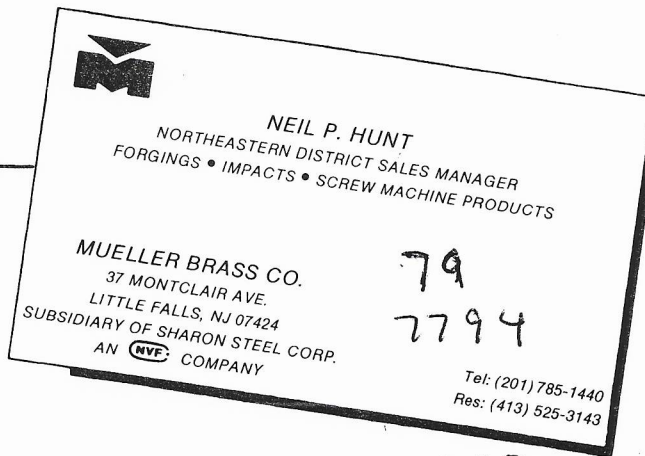

Completed
6-23-05
4" CONDUIT
AND INNER DUCT

7792
- 150

7642

