



Vellano Bros., Inc.

877-VELLANO (835-5266) www.vellano.com

Your Single Source for Pipe, Equipment, and Supplies for
Underground Water, Sewer, and Drainage Systems

(2)


Serving
The Northeast &
Midwest

Pipeline Specialists



Everett J. Prescott, Inc.

24 Hour
Emergency
Service

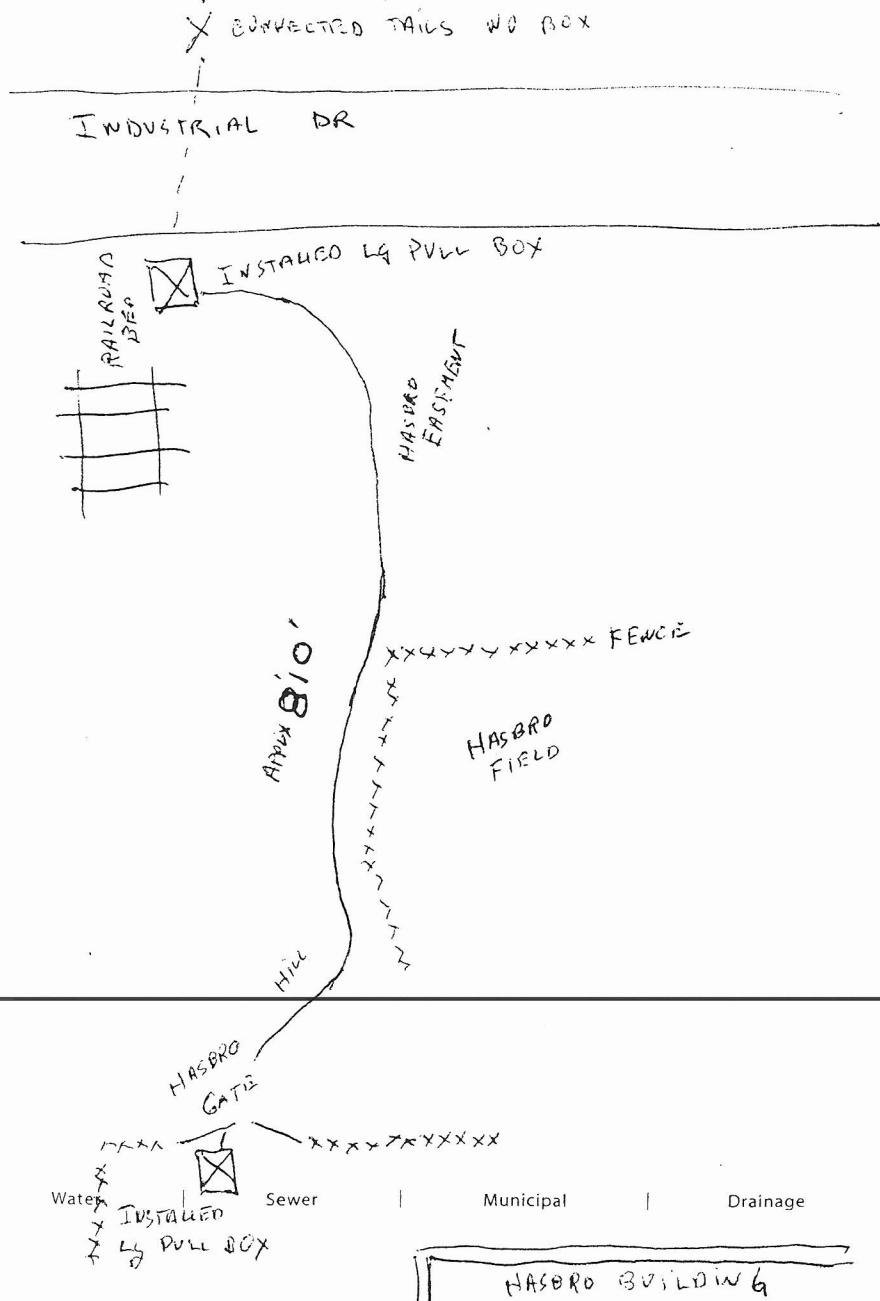


SHAKER Rd

118
227
345



170

MAINE ST

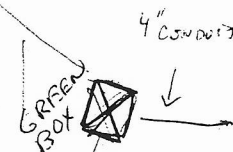

118'

TOWN HALL

9' TAILS

SPICED TOGETHER

227?



INSTALLED

4" CONDUIT
4 ROWS



10' TO END
(4) 4" CONDUIT 24" DEEP

MAP NODE

Water • Sewer • Drain • Gas

For your nearest EJP office call: **1-800-EJP-24HR**

www.ejprescott.com

e-mail: ejp@ejprescott.com