


Serving
The Northeast &
Midwest

Pipeline Specialists



Everett J. Prescott, Inc.

24 Hour
Emergency
Service

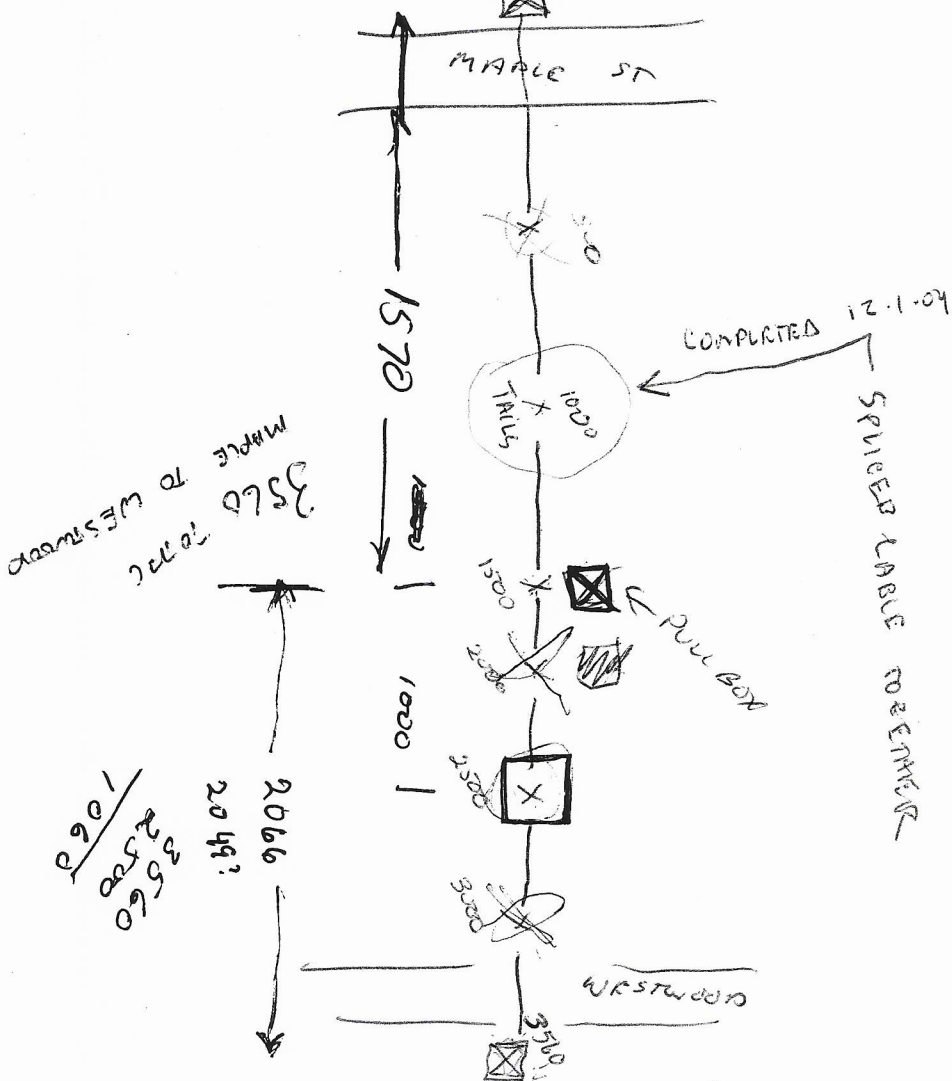

Water • Sewer • Drain • Gas

For your nearest EJP office call: 1-800-EJP-24HR


www.ejprescott.com

e-mail: ejp@ejprescott.com

Serving
The Northeast &
Midwest



24 Hour
Emergency
Service

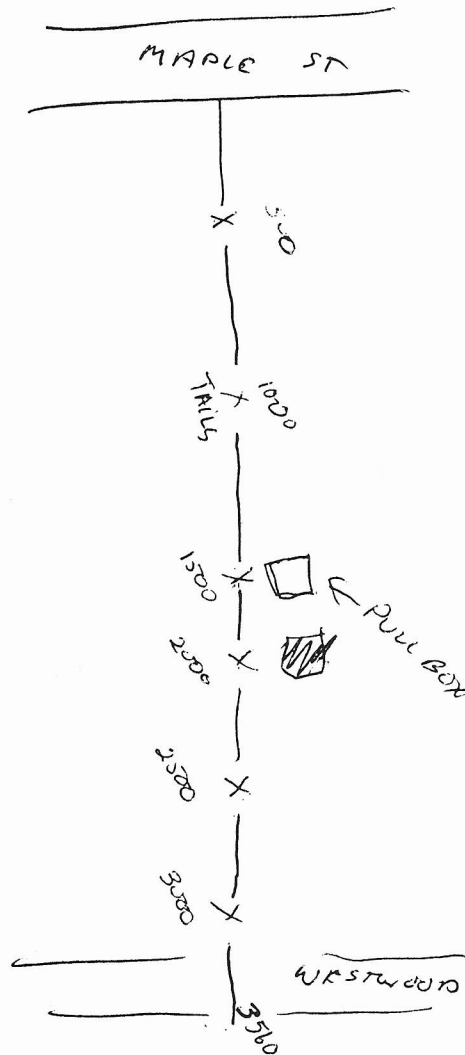

Water • Sewer • Drain • Gas

For your nearest EJP office call: **1-800-EJP-24HR**


www.ejprescott.com

e-mail: ejp@ejprescott.com

**24 Hour
Emergency
Service**

TEAM **JPA**

Everett J. Prescott, Inc.

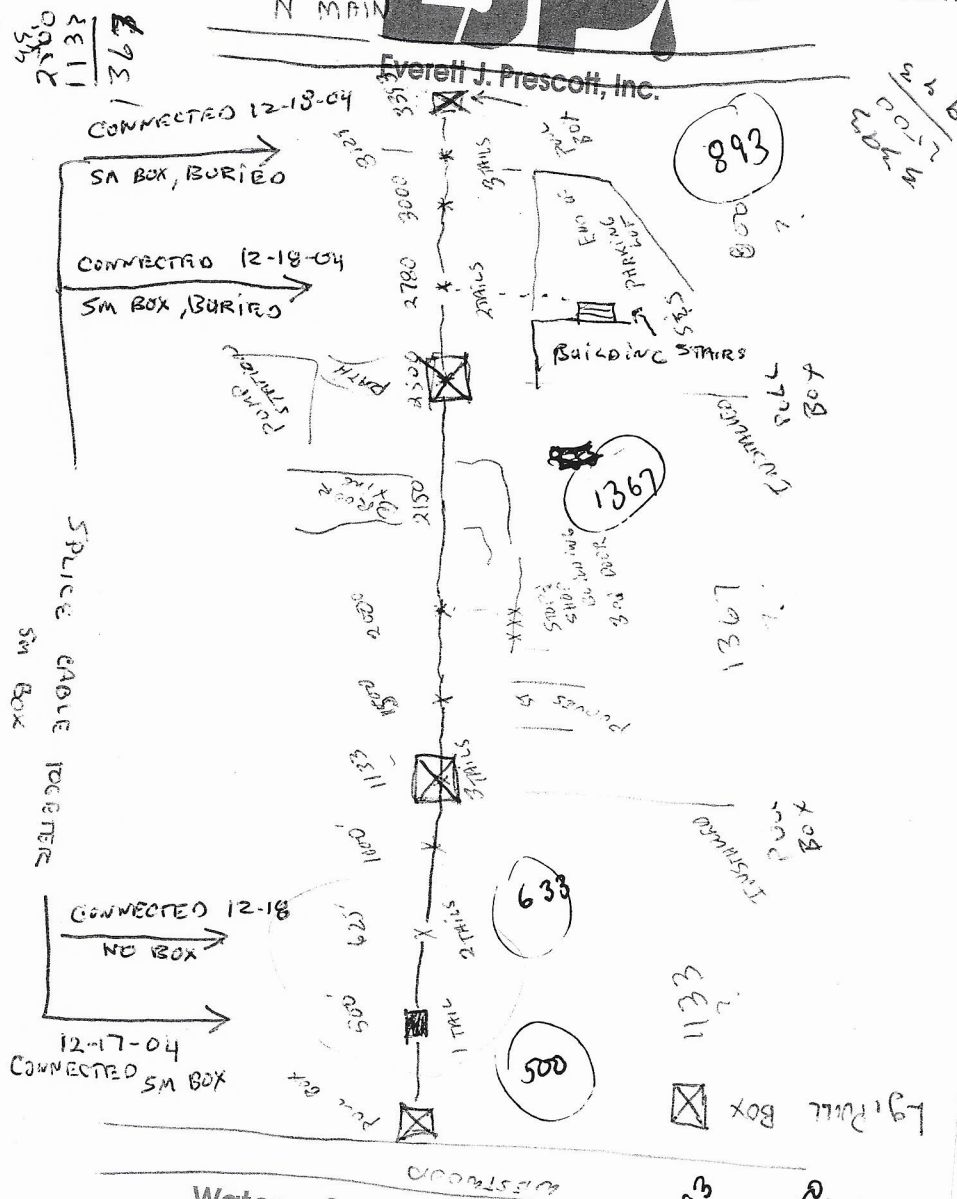

Water • Sewer • Drain • Gas

or your nearest EJP office call: **1-800-EJP-24HR**


www.ejprescott.com

e-mail: ejp@ejprescott.com

Pipeline Specialists

TEAM EJP

~~Everett J. Prescott, Inc.~~

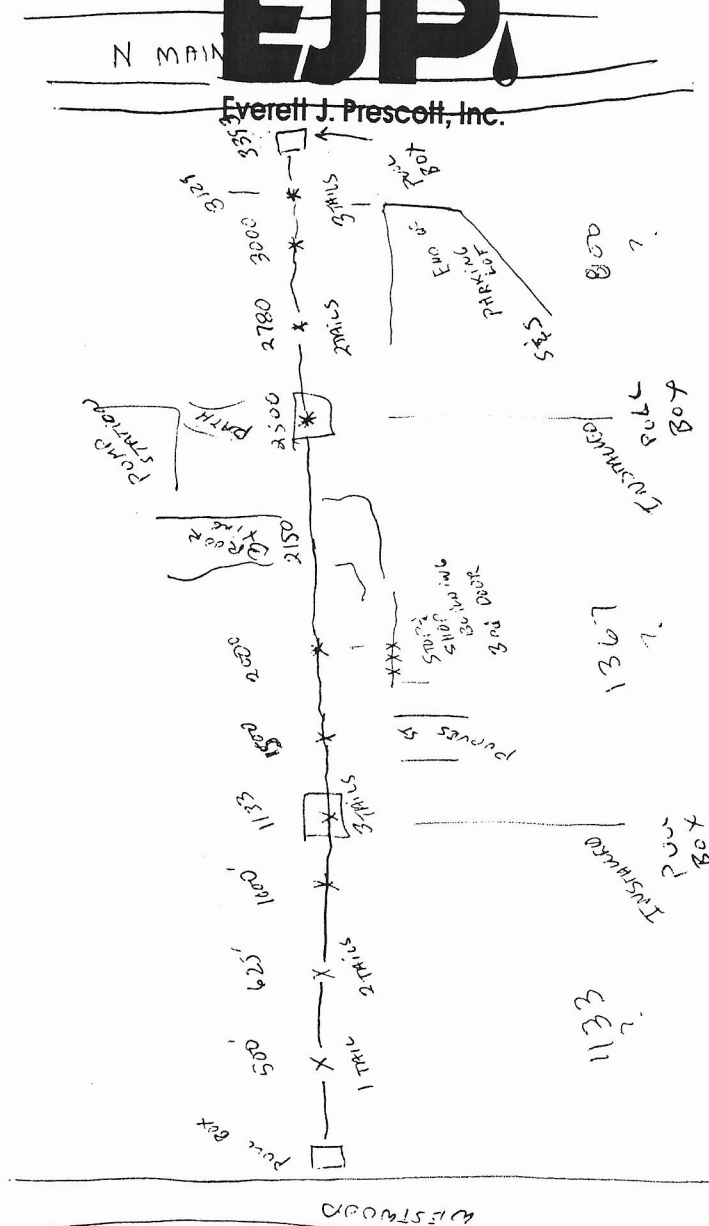

e-mail: ejp@ejprescott.com


Serving
The Northeast &
Midwest

Pipeline Specialists

24 Hour
Emergency
Service



Everett J. Prescott, Inc.

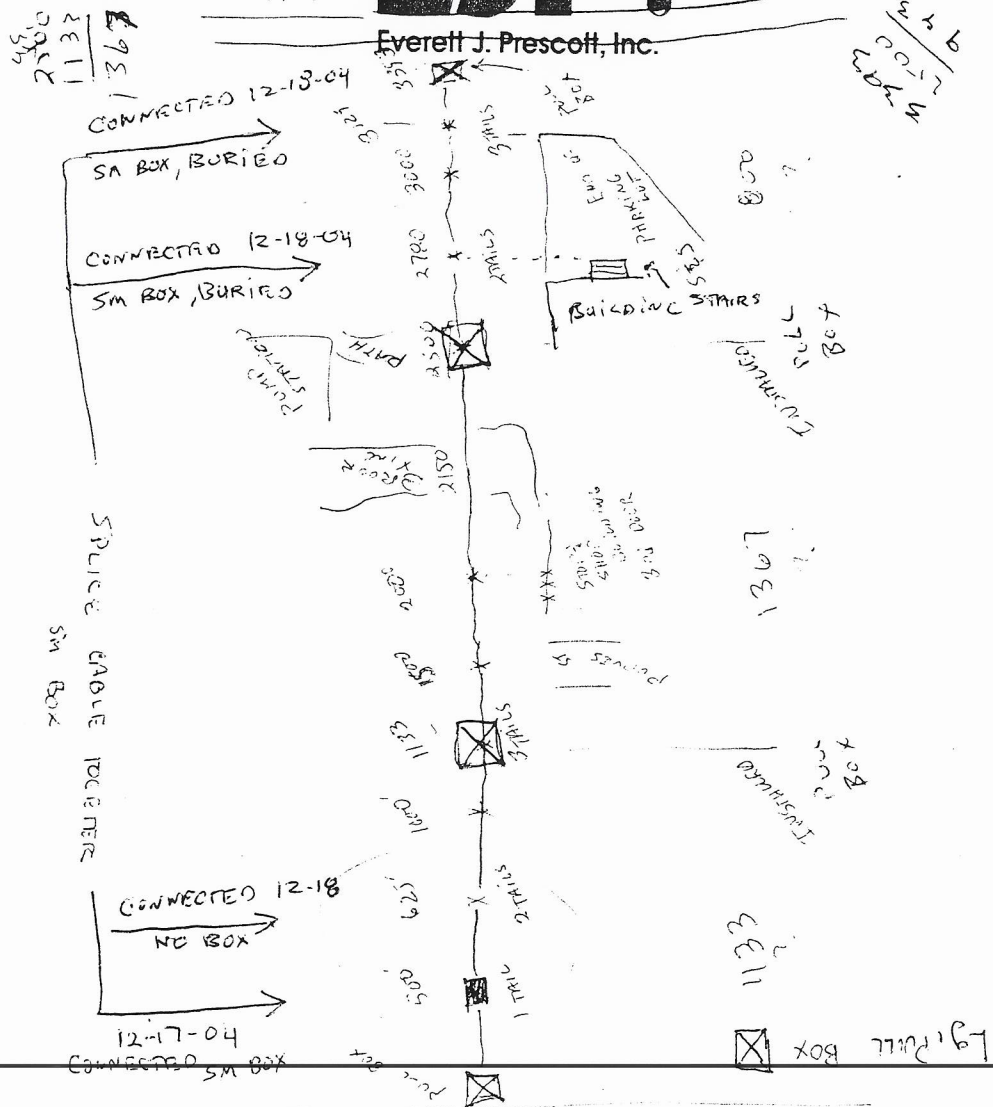

Water • Sewer • Drain • Gas

For your nearest EJP office call: 1-800-EJP-24HR

www.ejprescott.com


e-mail: eip@ejprescott.com

e-mail: eip@ejprescott.com

www.ejprescott.com

For your nearest EJP office call: 1-800-EJP-24HR

Water • Sewer • Drain • Gas

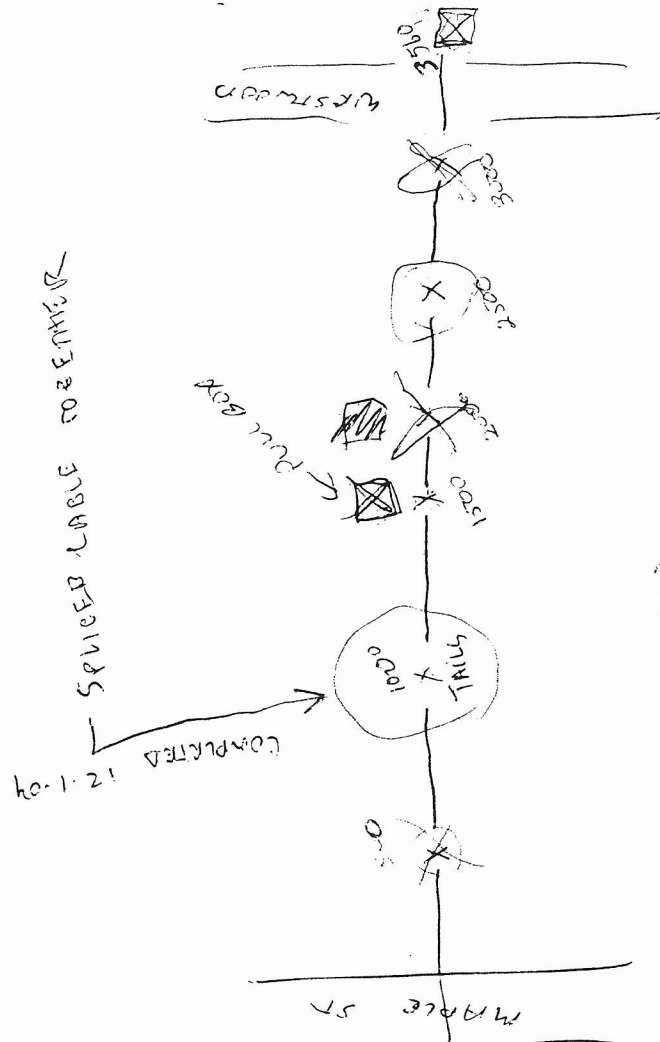

3560 TO MC
MADE TO WESTWOOD

Everett J. Prescott, Inc.



Pipeline Specialists

24 Hour
Emergency
Service

Serving
The Northeast &
Midwest

Serving
The Northeast &
Midwest

Pipeline Specialists



Everett J. Prescott, Inc.

24 Hour
Emergency
Service

2480

PUMPING
STATION

PULL BOX

CHESTNUT ST

NO BOXES

NEEDS TO
BE INSTALLED
HIGH
(INSTALLED
2-05)

NEEDS
TO BE
REPAIRED
1-14-05

SM BOX

PULL BOX INSTALLED

419 BRICK CROSSING

3 TAILS

INSTALLED GREEN BOX
TAILS CONNECTED 12-1-04

SM BOX INSTALLED

1000' PULL BOX
3 TAILS INSTALLED
11-23

Lg PULL BOX
SM BOX


PULL BOX 1925

MAPLE ST

Water • Sewer • Drain • Gas

SPICE
CABLE TOGETHER
INSTALL
SM BOX

to
be
installed

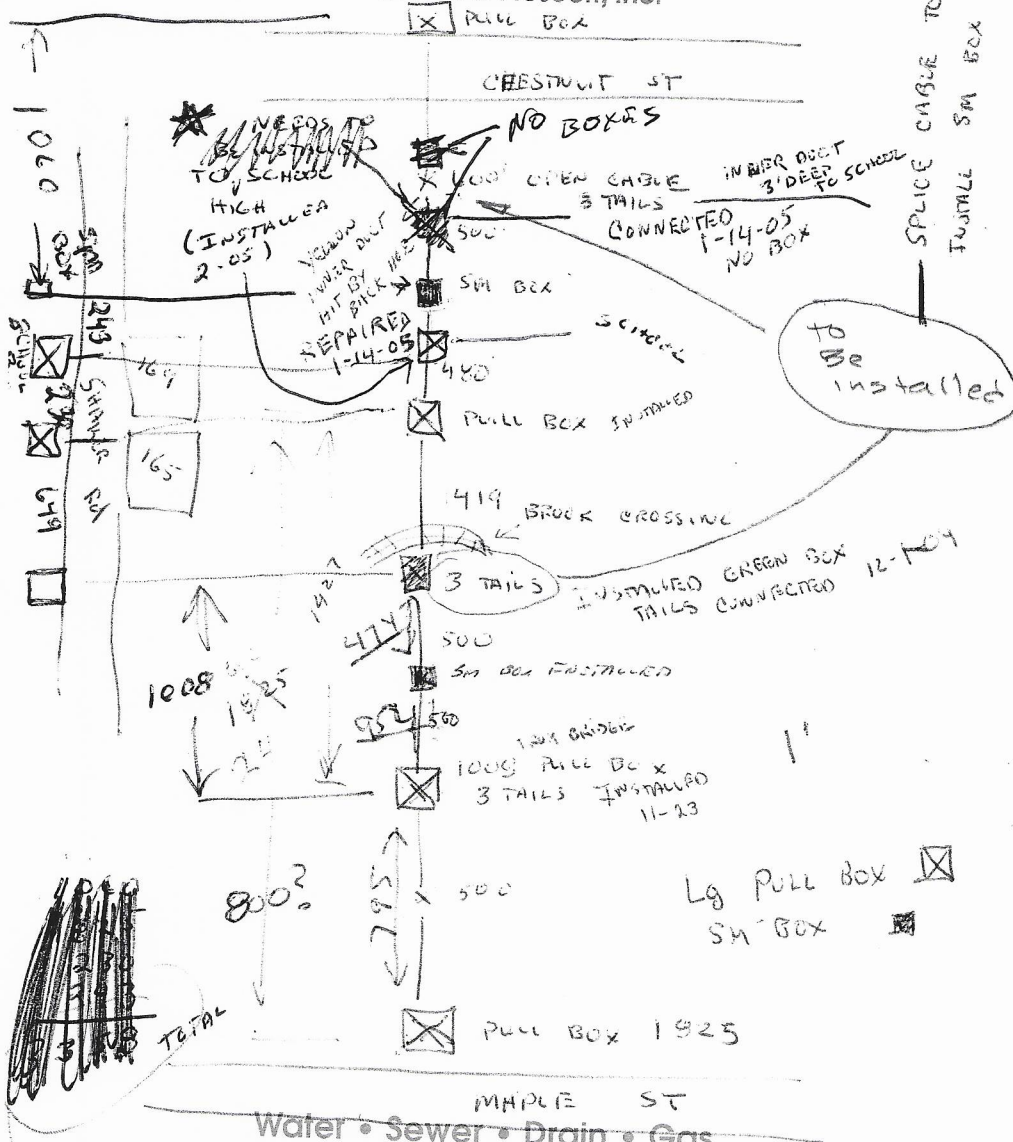

For your nearest EJP office call: 1-800-EJP-24HR

www.ejprescott.com

e-mail: ejp@ejprescott.com

5244 INDUSTRIAL
TO MAPLE

Serving
The Northeast &
Midwest


Pipeline Specialists



Everett J. Prescott, Inc.

24 Hour
Emergency
Service

1886 TOTAL

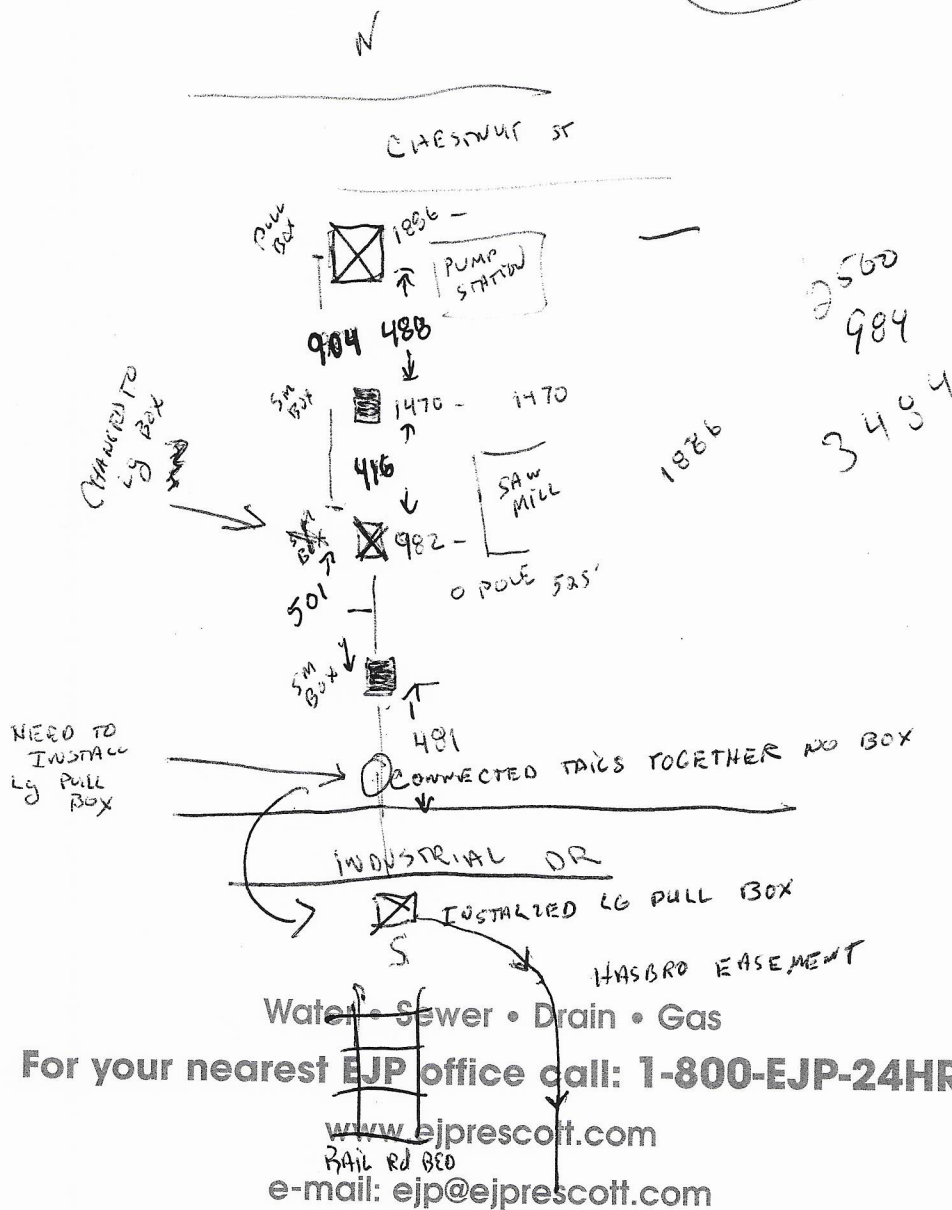



Vellano Bros., Inc.


877-VELLANO (835-5266) www.vellano.com

Your Single Source for Pipe, Equipment, and Supplies for
Underground Water, Sewer, and Drainage Systems

(2)

X CONNECTED TAILS NO BOX

INDUSTRIAL DR

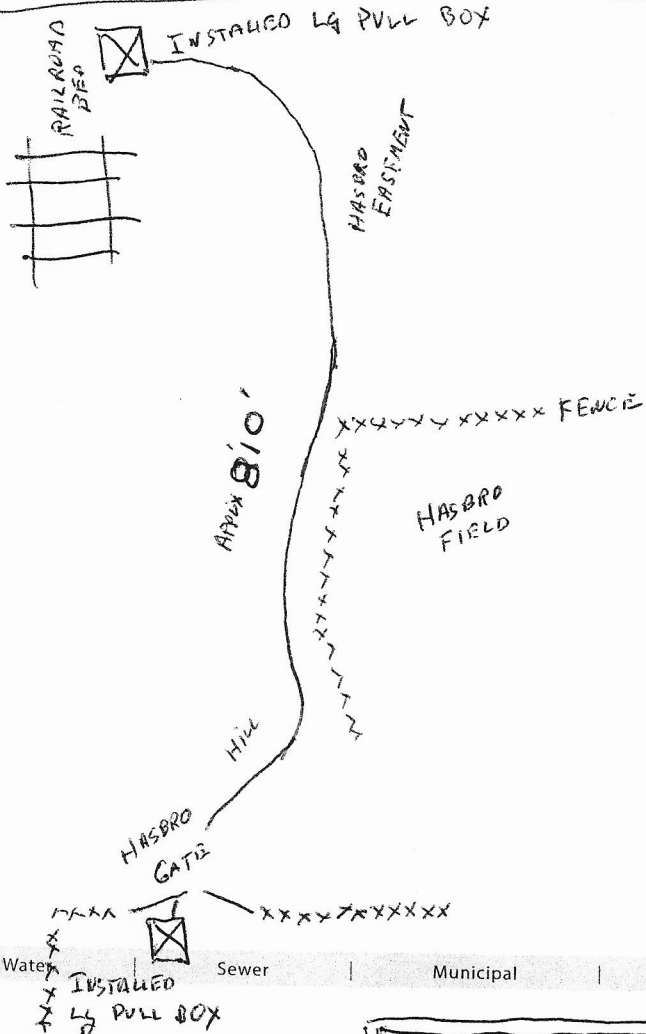

HASBRO BUILDING




Vellano Bros., Inc.

877-VELLANO (835-5266) www.vellano.com

Your Single Source for Pipe, Equipment, and Supplies for
Underground Water, Sewer, and Drainage Systems

①

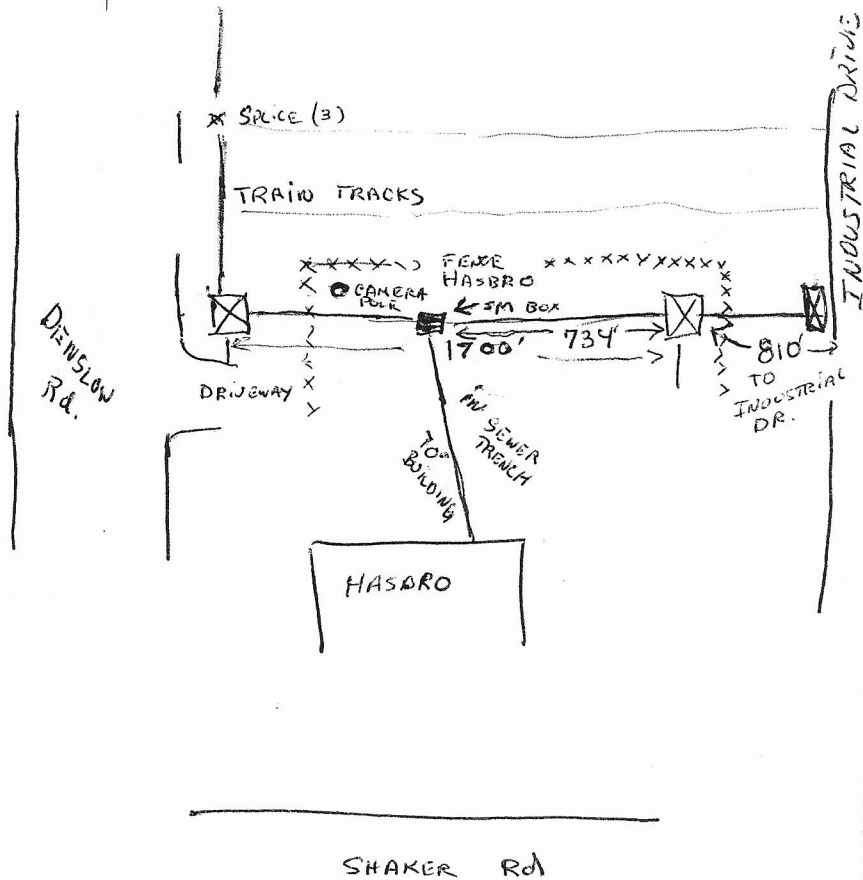

Water

Sewer

Municipal

Drainage