

Streamline[®]
PRODUCTS

WATER BUILDING




NEIL P. HUNT
NORTHEASTERN DISTRICT SALES MANAGER
FORGINGS • IMPACTS • SCREW MACHINE PRODUCTS

MUELLER BRASS CO.
37 MONTCLAIR AVE.
LITTLE FALLS, NJ 07424
SUBSIDIARY OF SHARON STEEL CORP.
AN **NVE** COMPANY

Tel: (201) 785-1440
Res: (413) 525-3143

SERVICE BUILDING
RT 83

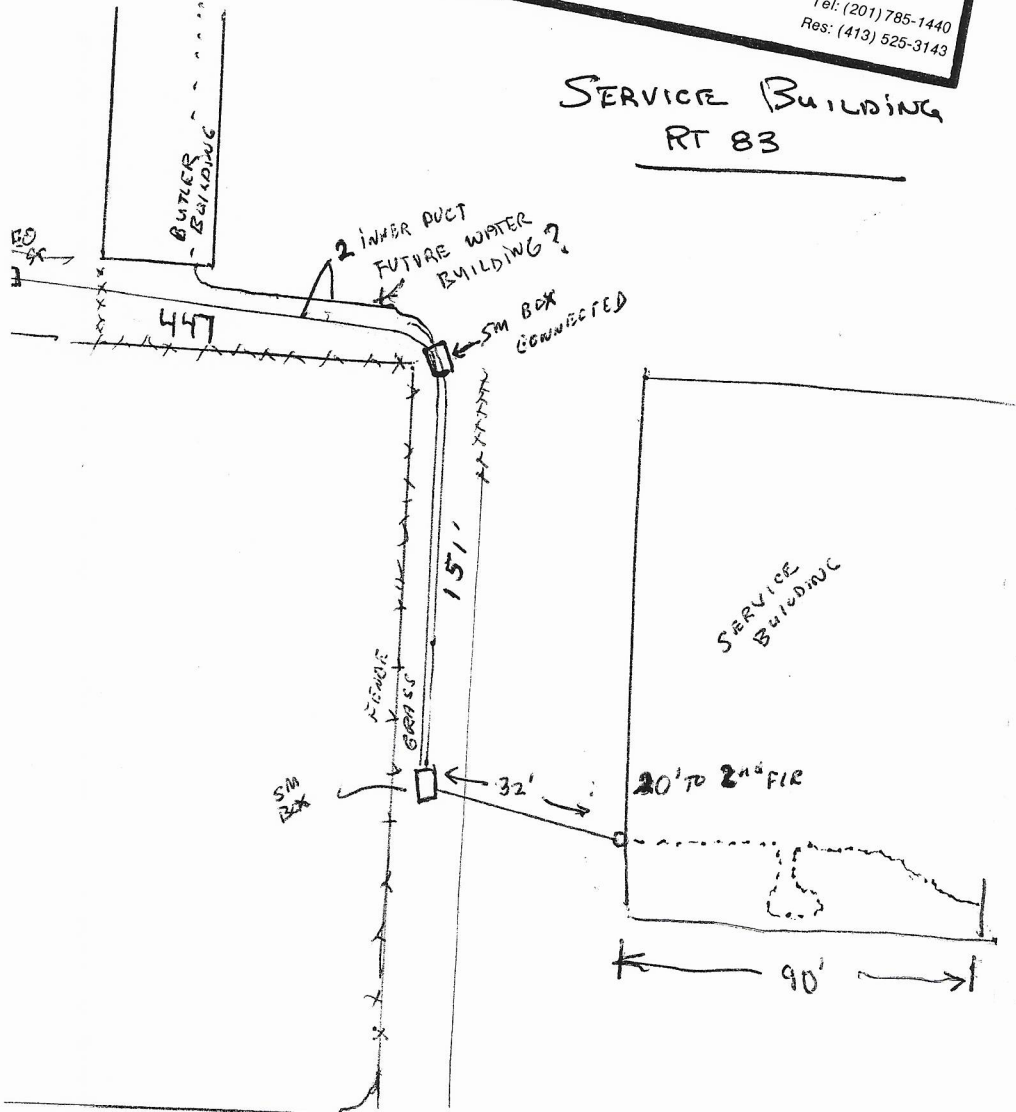



NEIL P. HUNT
NORTHEASTERN DISTRICT SALES MANAGER
FORGINGS • IMPACTS • SCREW MACHINE PRODUCTS

MUELLER BRASS CO.
37 MONTCLAIR AVE.
LITTLE FALLS, NJ 07424
SUBSIDIARY OF SHARON STEEL CORP.
AN  COMPANY

Tel: (201) 785-1440
Res: (413) 525-3143

