


SOMERS ROAD

POLICE STATION
TO MOUNTAINVIEW
SCHOOL

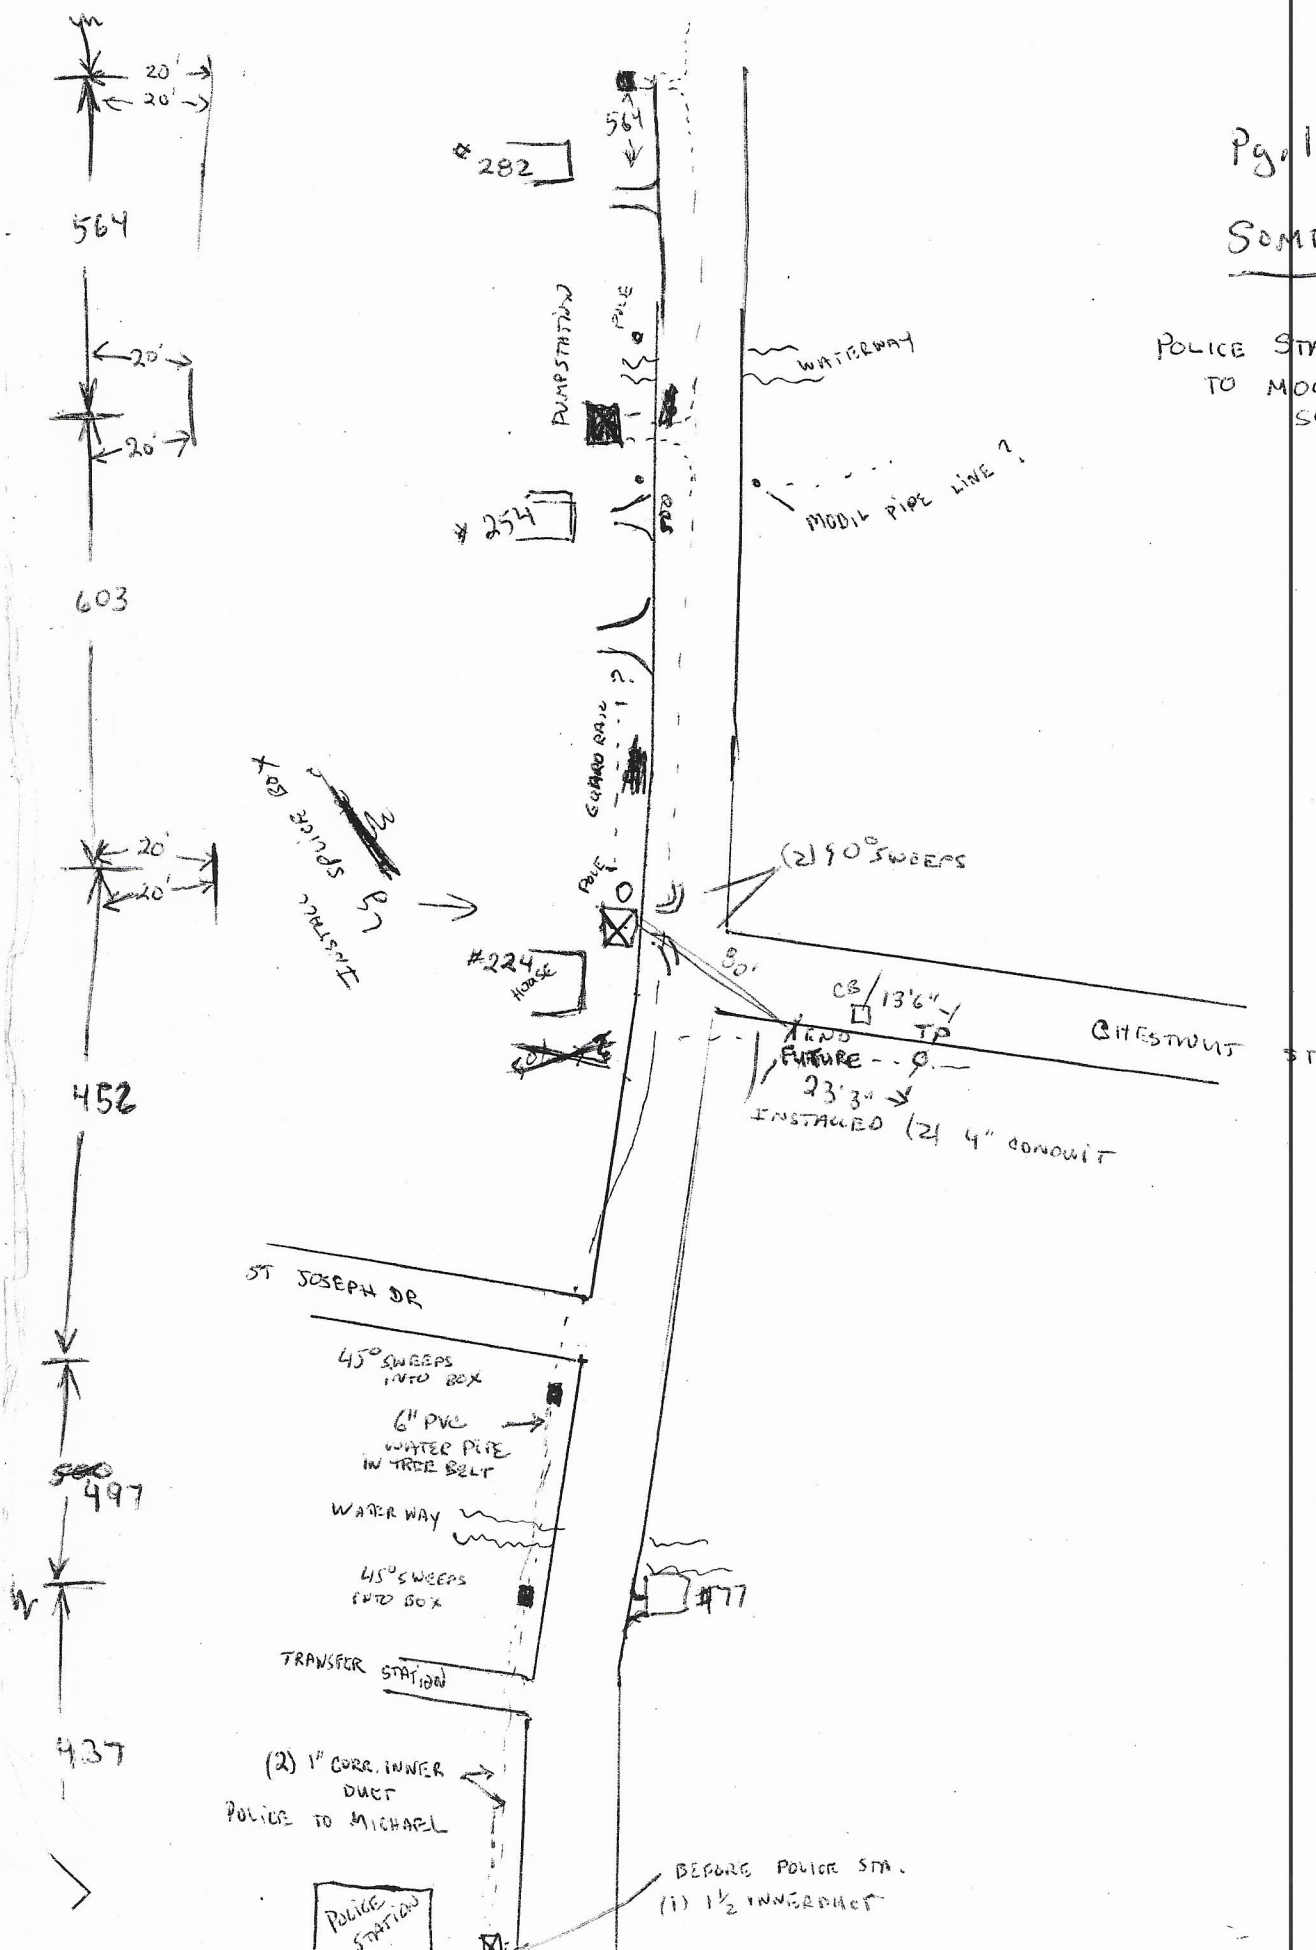

MT VIEW SCHOOL DRIVEWAY

HYDRANT
TEL
POLE

4" PVC PIPE
SCH 40 THROUGH
DRIVEWAYS

GUARD RAIL

12" INHERENT
INSTALLED
1' OFF EDGE
OF ROAD

HAMPDEN Rd

150'
4' CONDUIT

4344

Pg. 3

RT 83

SOMERS ROAD

POLICE STA: TO MT. VIEW
SCHOOL