



EAST LONGMEADOW DEPARTMENT OF PUBLIC WORKS


Job: 100 Hampden Rd (Sewer)

Sheet No: _____ of _____

Calculated By: Pape

Date 7-29-17

Scale: _____

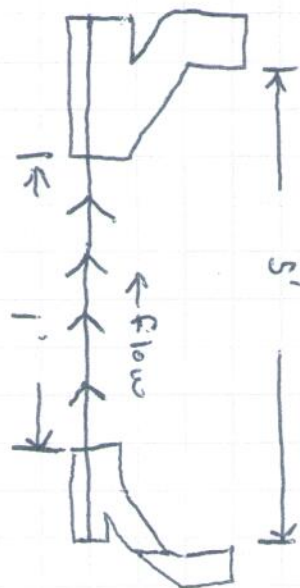

Note: Clean out #1 goes toward the house and is a 45° sweep going into a 4" Y

Clean out #2 goes toward the main in the street and has a 45° Street Fitting going into a 4" Y

They are at a depth of 5'

Hampden Rd

