


No. Street 20 (San. Sewer) ✓ Lot No. 8/16/04
ABBEY LANE Inspected

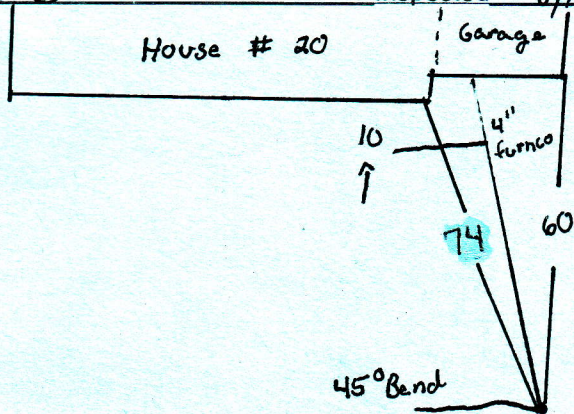

Ball Connection 8' deep