




WATER • WASTEWATER • STORMWATER
SOLUTIONS

JOB 5 Albany Dr

SHEET NO. _____ OF _____

CALCULATED BY Josh @ Josh F DATE 2-15-19

SCALE Sewer man hole

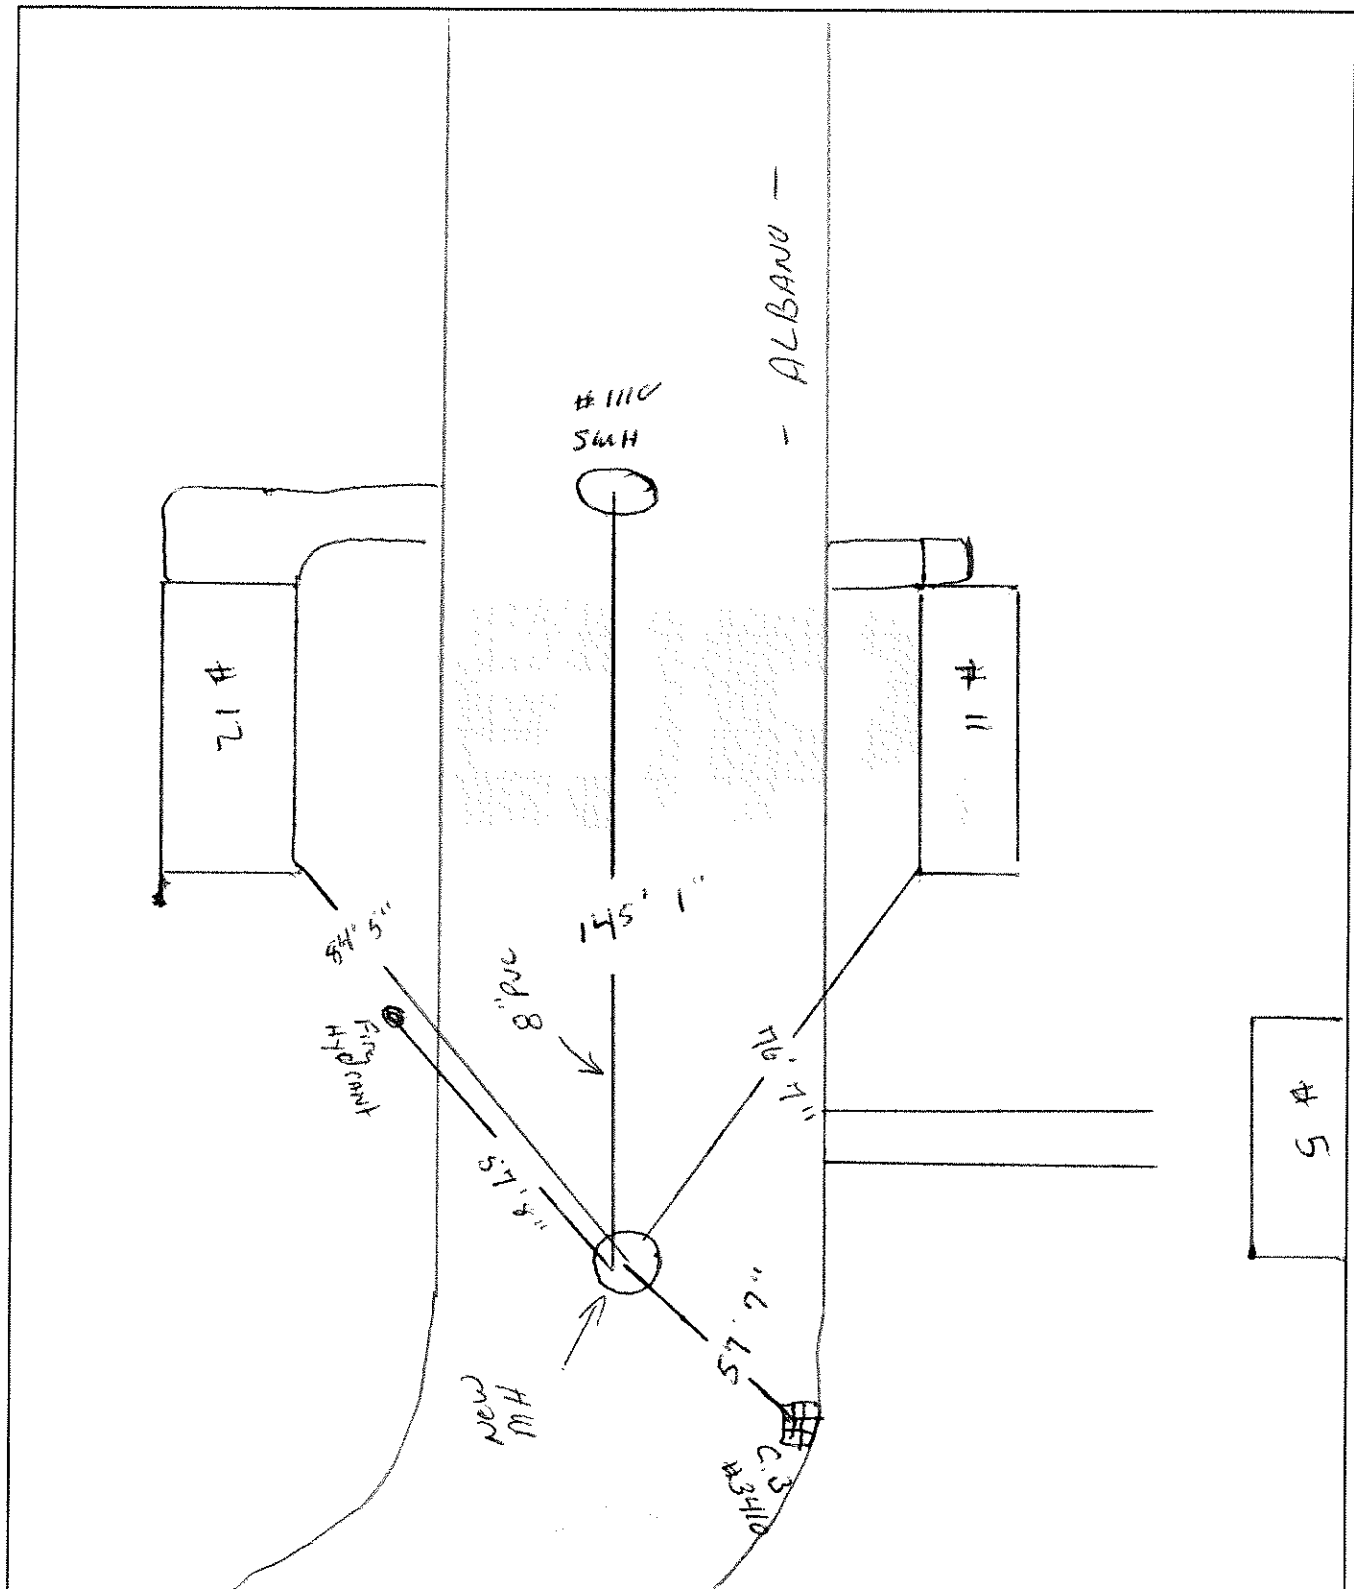

MANHOLE INSPECTION FORM

Inspector: Josh F, Josh C

Date: 2-15-2019

Location: 5 Albano Dr

MH ID: _____

Present Use: Storm ☒ Sanitary ☐ Other _____

Surface Cover: Paved

Grade to Manhole: Flush Below _____ Above _____

Cover Diameter: 20"

Cover Condition: ☒ Good ☐ Fair ☐ Poor

Riser Rings: Number _____ Alignment: _____

Casting Condition: ☒ Good ☐ Fair ☐ Poor

Manhole Type: ☒ Precast ☐ Brick ☐ Block ☐ Combination

Manhole Condition: ☒ Good ☐ Fair ☐ Poor

Step Condition: Good ☐ Fair ☐ Poor

Type: Re-rod ☐ Cast ☐ Reinf. Plastic ☐ Other _____

Apron Condition: ☒ Good ☐ Fair ☐ Poor

Drop Manhole: Yes ☐ No ☒

Type: Outside ☐ Inside ☐

Infiltration: Yes ☐ No ☒

Where: Pipe ☐ Invert ☐ Casting ☐ Walls ☐

Comments: _____

N
↑
Inlets and Outlets
(By Clock Position)

