

No. Street


(San. Sewer)

Lot No.

186 ALLEN ST,

Inspected

10-5-12

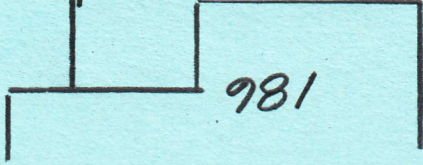

3.5' DEEP
PERMANENT

1/2" 24

25

1/2" 25