


4-8-11
RJE

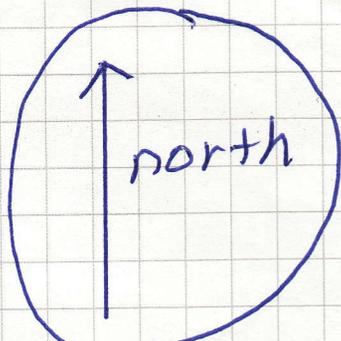

AUBURN Street

Thompson's Ave.

3-2" FS:S.
FOR
Lot D, E, + F

Serving
The Northeast &
Midwest

www.ejprescott.com
1-800-EJP-24HR

24 Hour
#
Emergency
37
Service
Thompson's