


No. Street _____ (San. Sewer) _____ Lot No. _____
S BALMORAL DRIVE Inspected 3-26-07

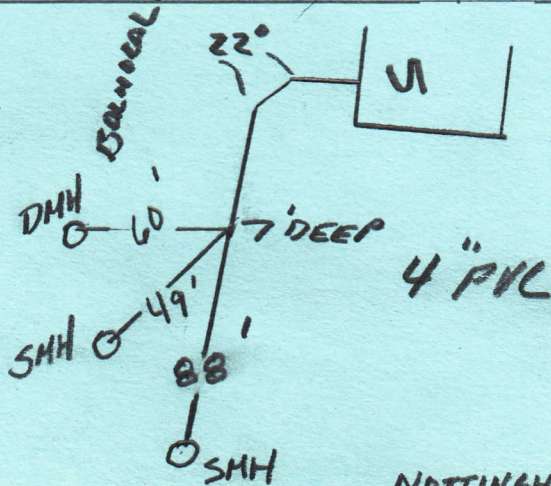

NOTTINGHAM