



EAST LONGMEADOW DEPARTMENT OF PUBLIC WORKS


Job: 75 Bayne

Sheet No: _____ of _____

Calculated By: Crochetiere Date 12.2.2021

Scale: Sewer Tie

House Service Repaired-Replaced
by Contractor

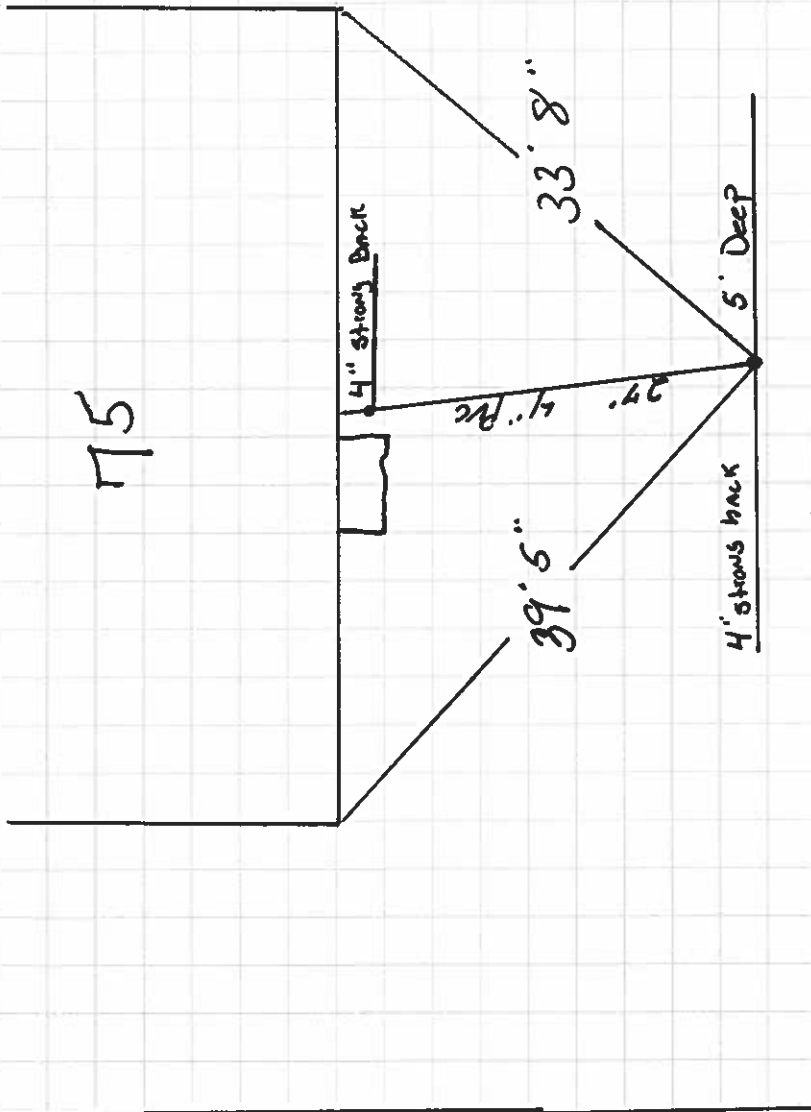

Glendale