


No. Street (San. Sewer) Lot No.
9 BLACK DOG LANE Inspected 9-7-12

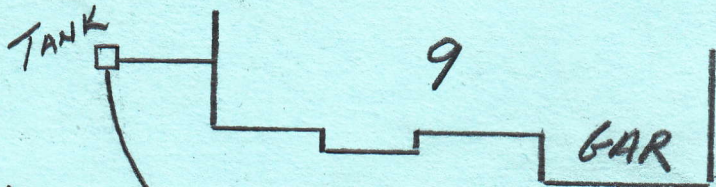

$1\frac{1}{4}$ " F.S.

HVD
⊗

66'

39'

⊗ C. BASIN

$1\frac{1}{4}$ " SEWER
CURB STOP
7' DEEP