


No. Street

(San. Sewer)

Lot No.

169 BRAEBURN RD. Inspected 9-19-12

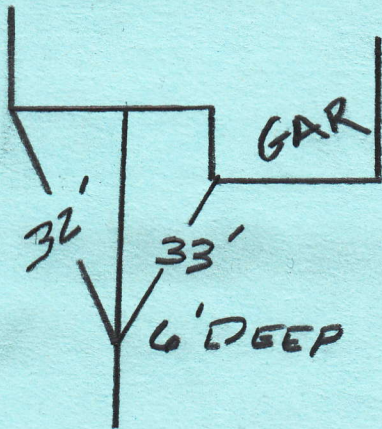

4" PVK

6' DEEP