

No. Street


(San Sewer)

Lot No.

86 CANTERBURY CIRCLE

Inspected

House # 86

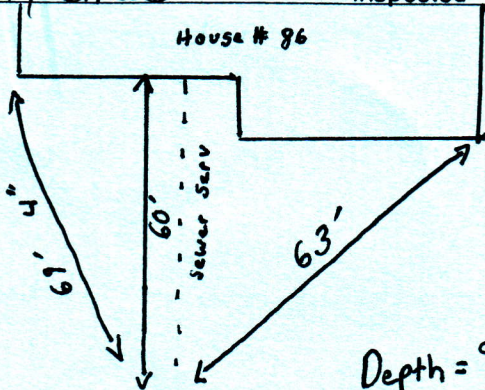

Depth = 9'