


EAST LONGMEADOW DEPARTMENT OF PUBLIC WORKS

Job: 191 Canterbury Circle (Sewer)

Sheet No: _____ of _____

Calculated By: Pope Date 1-10-19

Scale: _____

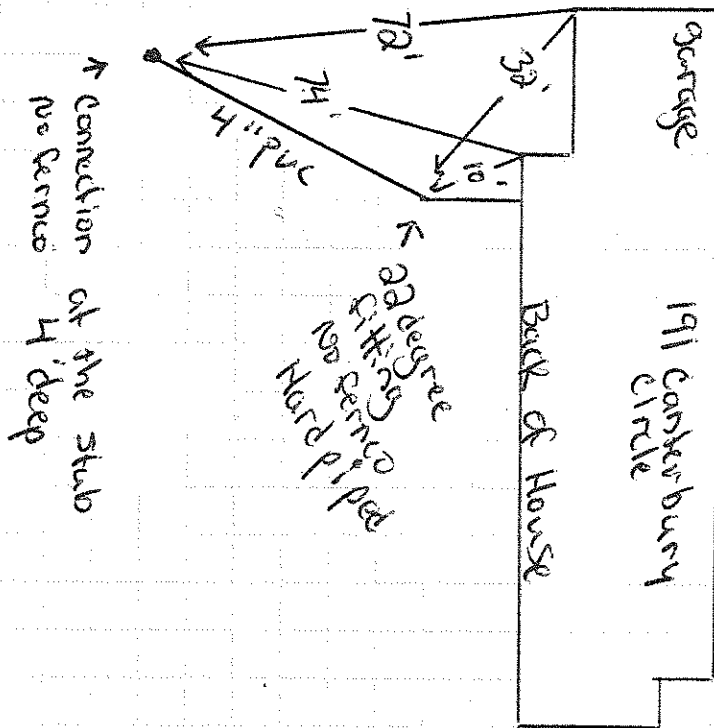

Canterbury Circle

Shaker Rd.