


No. Street 211 (San. Sewer) 9/7/06 Lot No. _____
Canterbury Circle Inspected _____

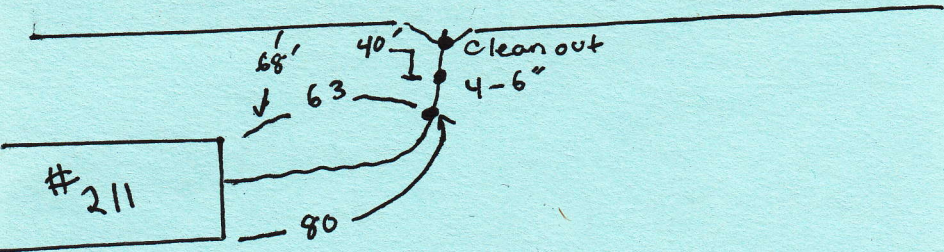

Canterbury