


No. Street 216 (San. Sewer) ☒ Lot No.
Canterbury Circle Inspected

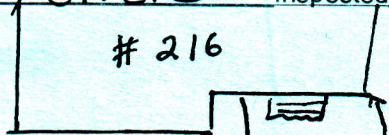

58'

85'

8' deep

4" Bell Connection