




EAST LONGMEADOW DEPARTMENT OF PUBLIC WORKS

Job: 41 CARVILL AVENUE
Sheet No: _____ of _____
Calculated By: Crachetiere Date 9-16-2020
Scale: New Sewer Connection



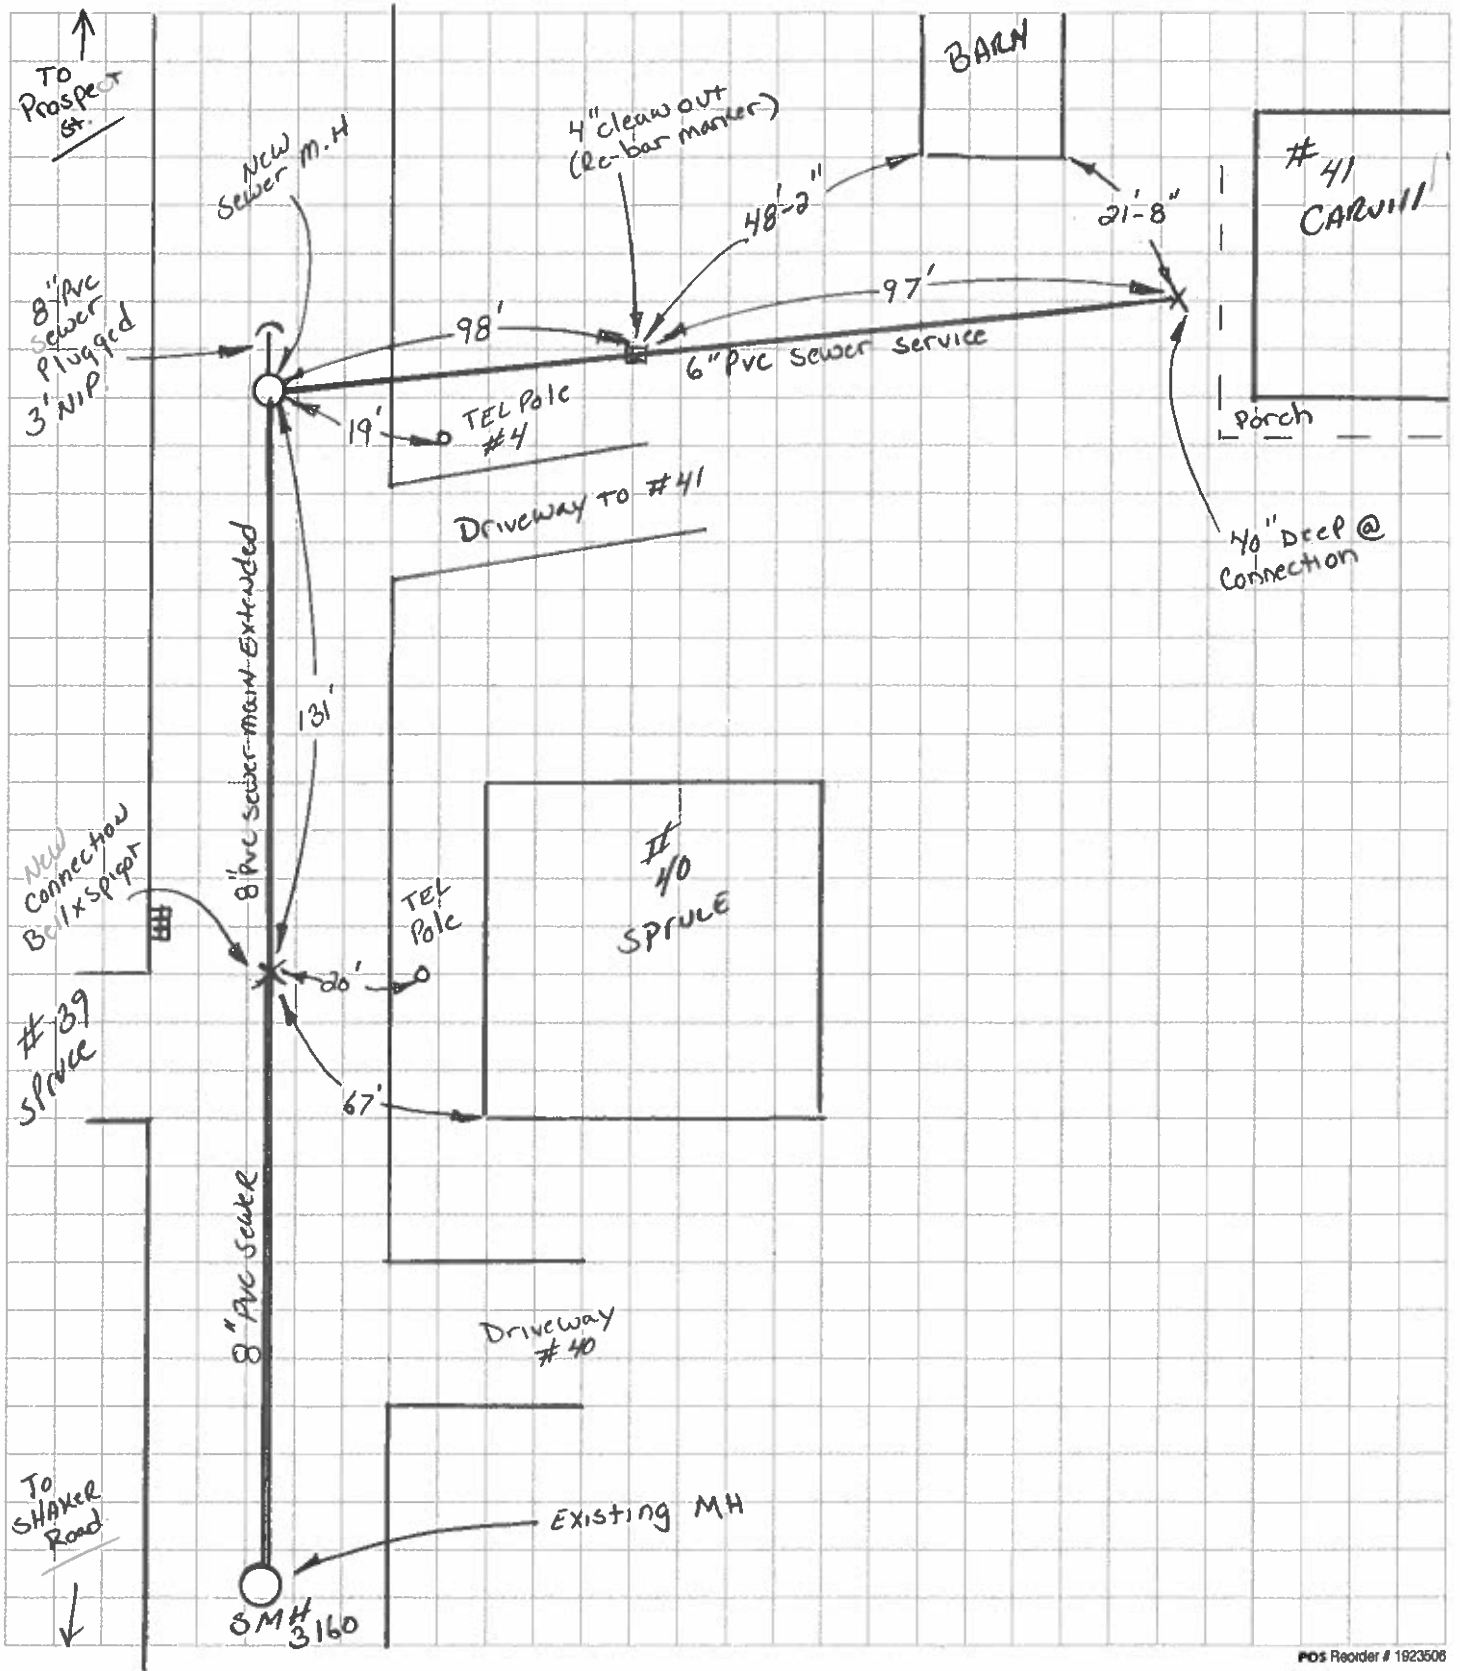

TOWN OF EAST LONGMEADOW
DEPARTMENT OF PUBLIC WORKS
60 CENTER SQUARE
EAST LONGMEADOW, MA 01028

Felix S. Vachon, Water & Sewer Administrator

felix.vachon@eastlongmeadowma.gov
(413) 525-5400 ext. 1204

September 16, 2020

Re: 41 Carvill Avenue

To whom it may concern,

The Property located at 41 Carvill Avenue has connected to the Town's Sanitary Sewer System. The septic tank was crushed and filled. A new 6" PVC pipe was laid to the Town's connection point at the new manhole located on Spruce Street. All aspects of the above were inspected by the Town inspector and approved. The sewer main on Spruce Street was extended (at the homeowner's expense) with new 8" PVC pipe and a new sewer manhole. The sewer main and manhole installation were constructed by Skinner Construction and inspected by the Town.

Regards,

Felix Vachon
Water and Sewer Administrator
Town of East Longmeadow Public Works



