


→ west

330 Chestnut

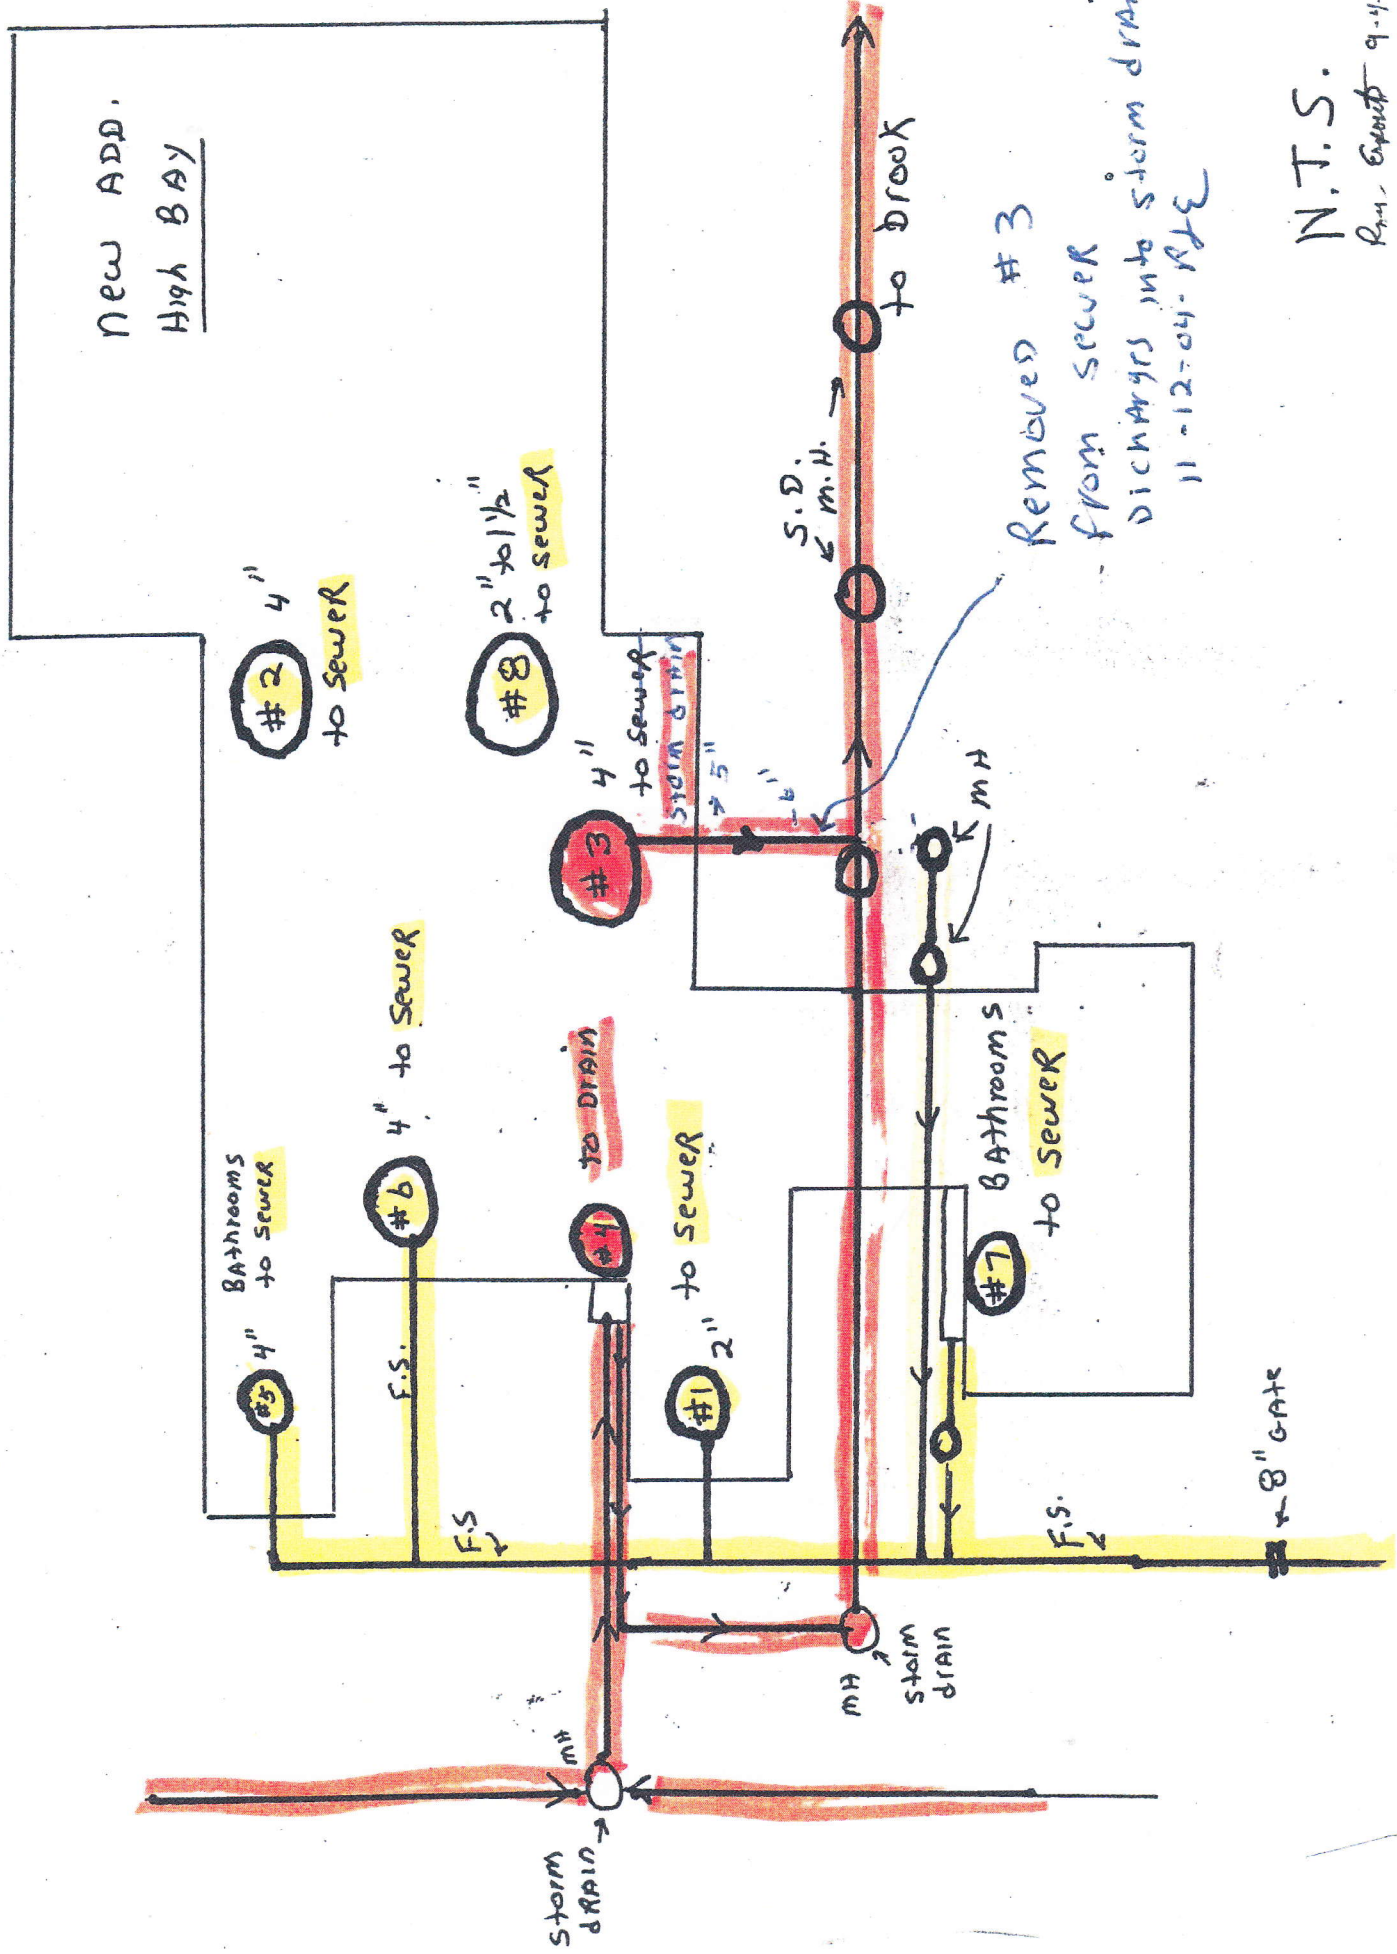

Removed #3
from sewer
discharges into storm drain
11-12-04- RJE

N.T.S.

Rm. Expects 9-11-04