




EAST LONGMEADOW DEPARTMENT OF PUBLIC WORKS

Job: 61 Colony Drive (Sewer)

Sheet No: _____ of _____

Calculated By: Ruel Date 10-3-17

Scale: _____

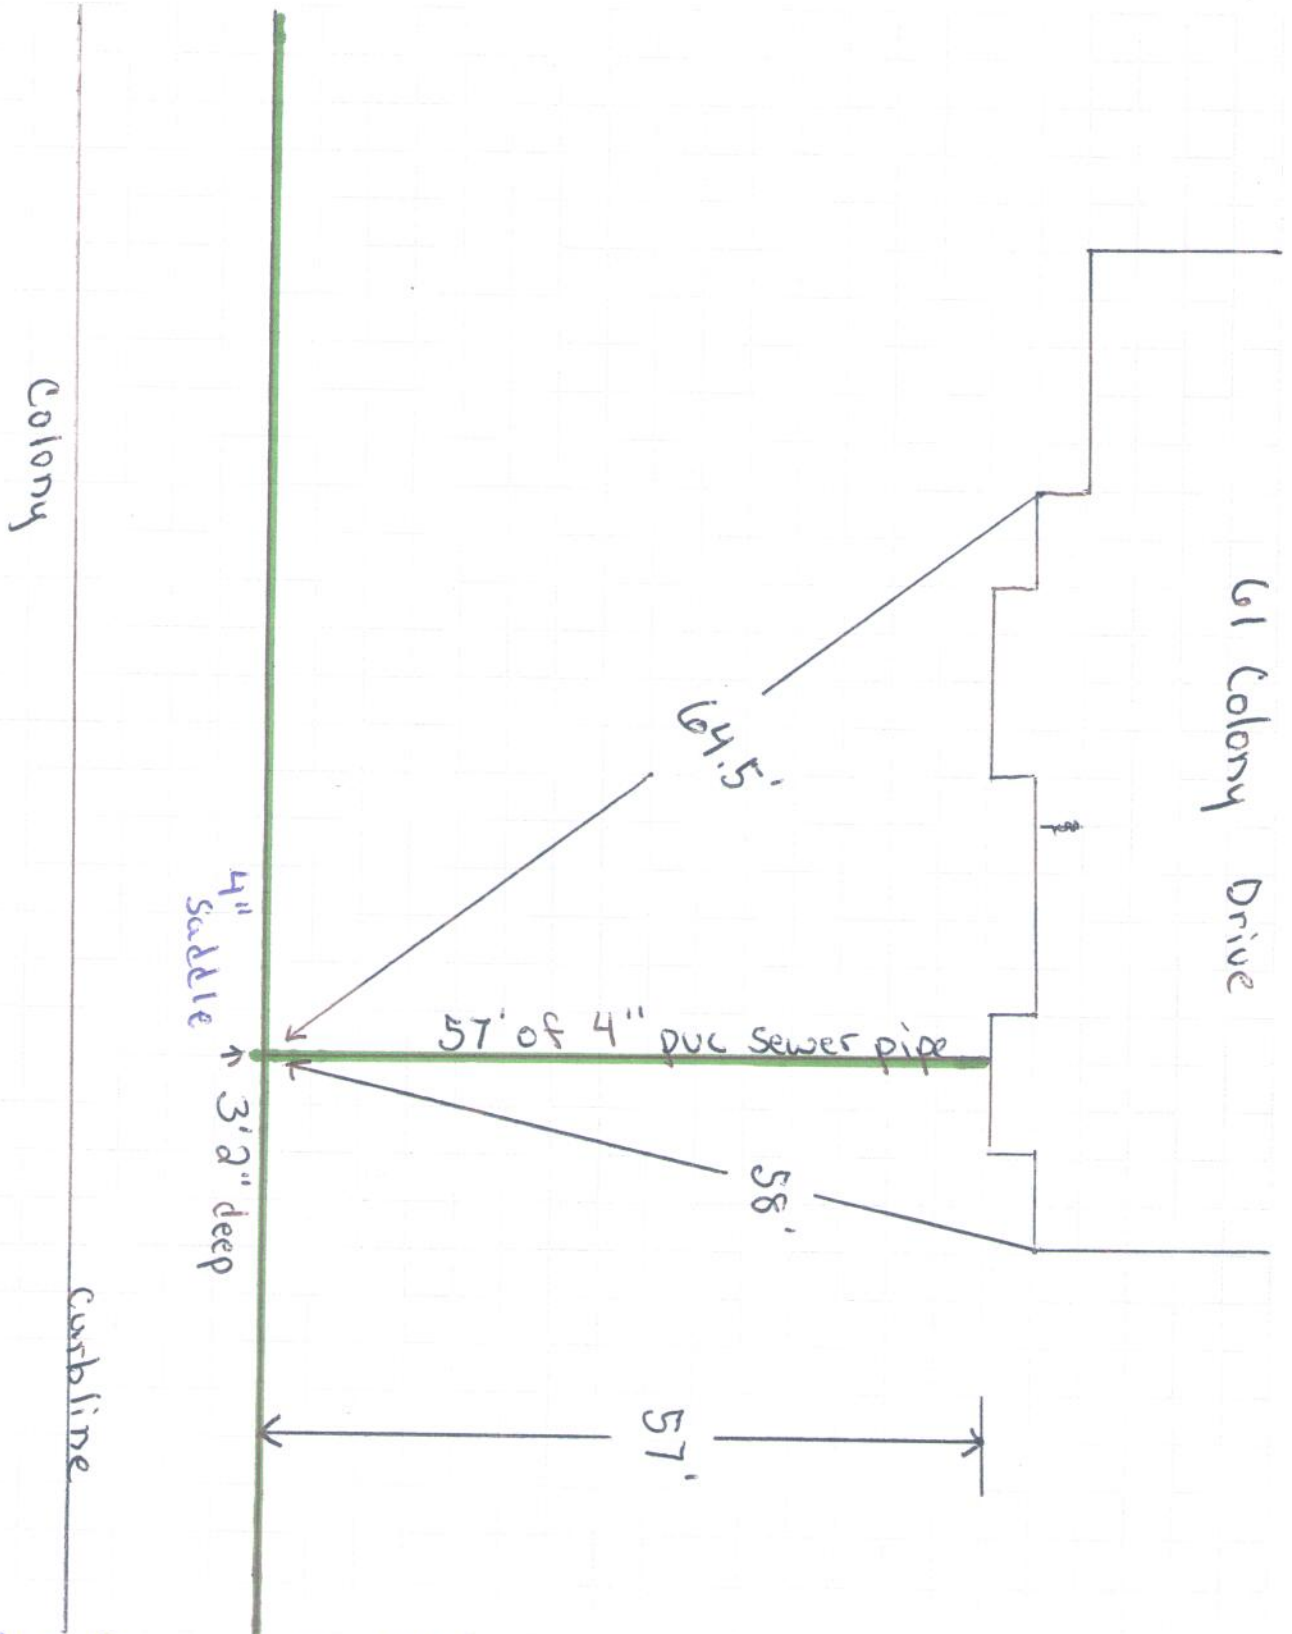

1010117 Scanned to GIS