

NO. STREET

DATE INST.

MAKE:


SIZE

15 DALE STREET

1/15/04

BADGER

1"

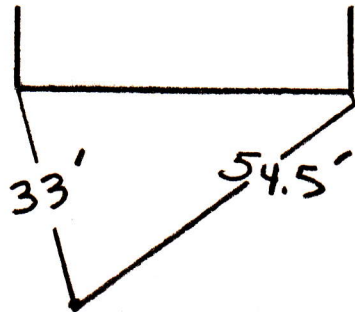

IN
DRIVEWAY