


EAST LONGMEADOW DEPARTMENT OF PUBLIC WORKS

Job: 51 Donald Ave (Sewer)
Sheet No: Contractor - Blue Ridge Excavation of
Calculated By: Pope Date: 4-22-21
Scale: _____

Donald Ave

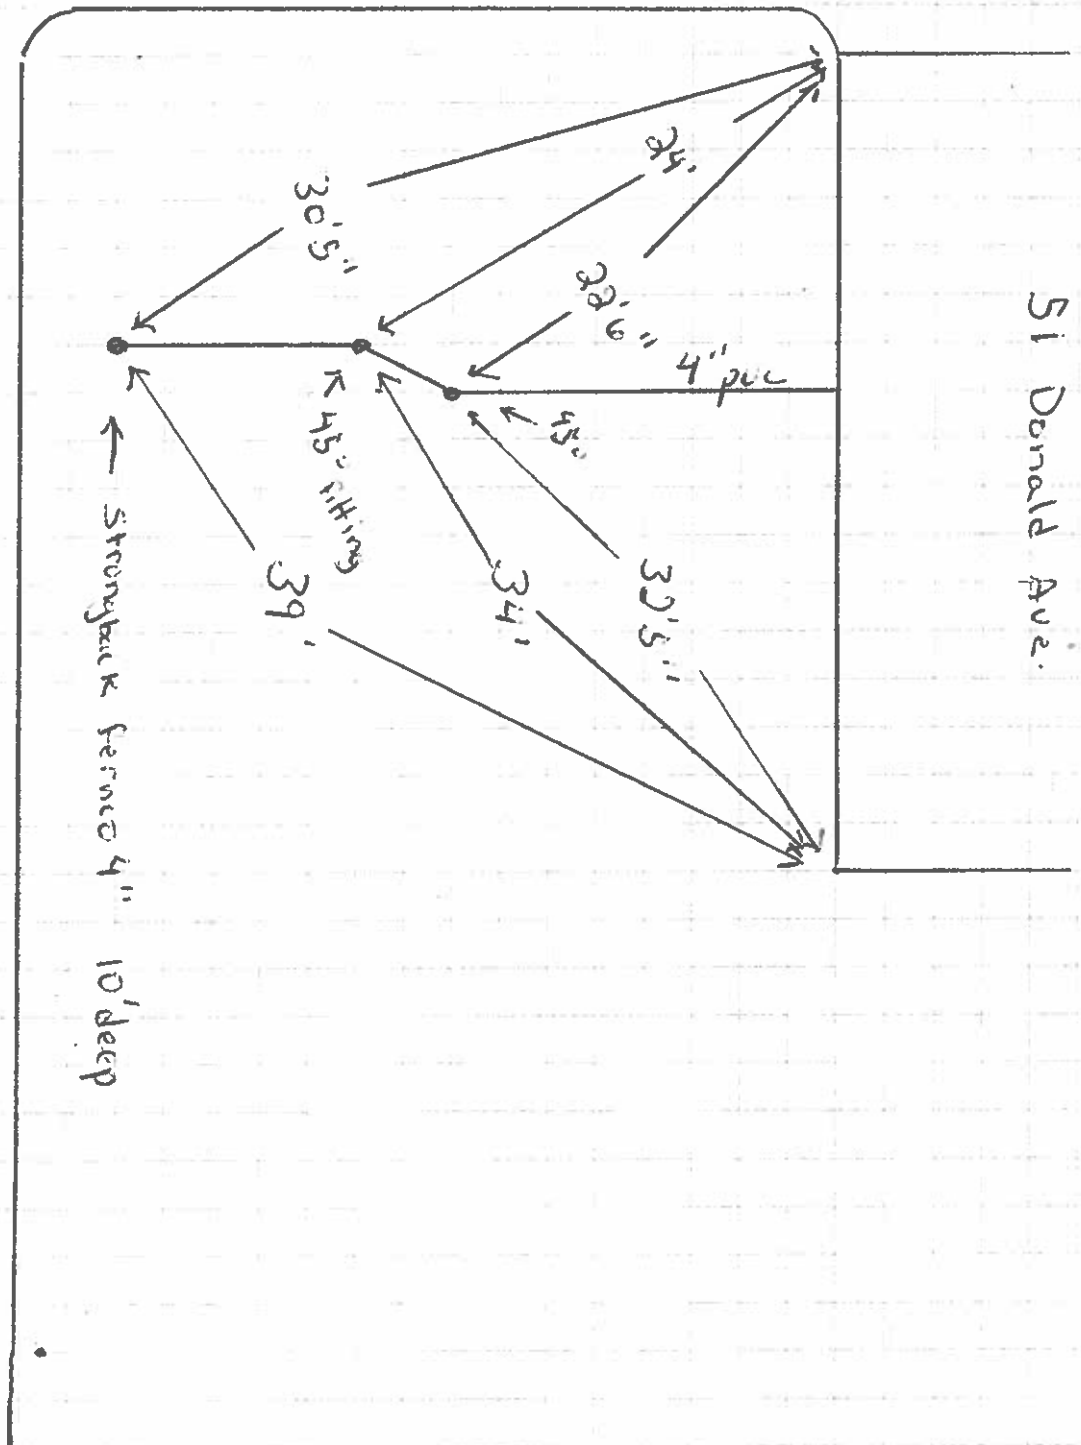

**TOWN OF EAST LONGMEADOW, MA
DEPARTMENT OF PUBLIC WORKS
SEWER INSPECTION**

DATE: 4-22-2021

Sanitary

Storm

Other

Size 4" pvc

Fee \$50.00

Inspected Yes

LOCATION OF PROPERTY: 51 Donald Ave

OWNER:

Is drain under cellar floor NO

Feet above cellar floor 2'

If building has cellar or footing drains, where do they discharge:

The above fee is for the initial inspection. If initial inspection is not approved, there will be an additional fee of \$25.00 for each inspection.

It is understood that only sanitary waste is to be connected to the sanitary sewer and only clean surface or sub-surface water to storm drain.

Thomas W. Pope

DPW Inspector