


No. Street

(San. Sewer)

Lot No.

19 EDWILL ROAD

Inspected 12-28-09

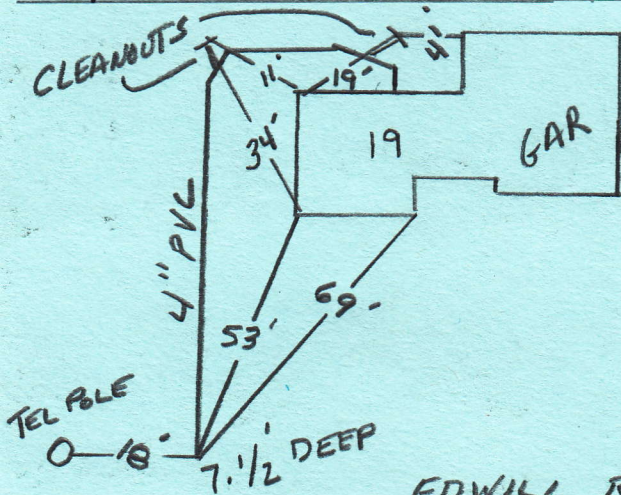

EDWILL ROAD