


SEWER - 12-18-11

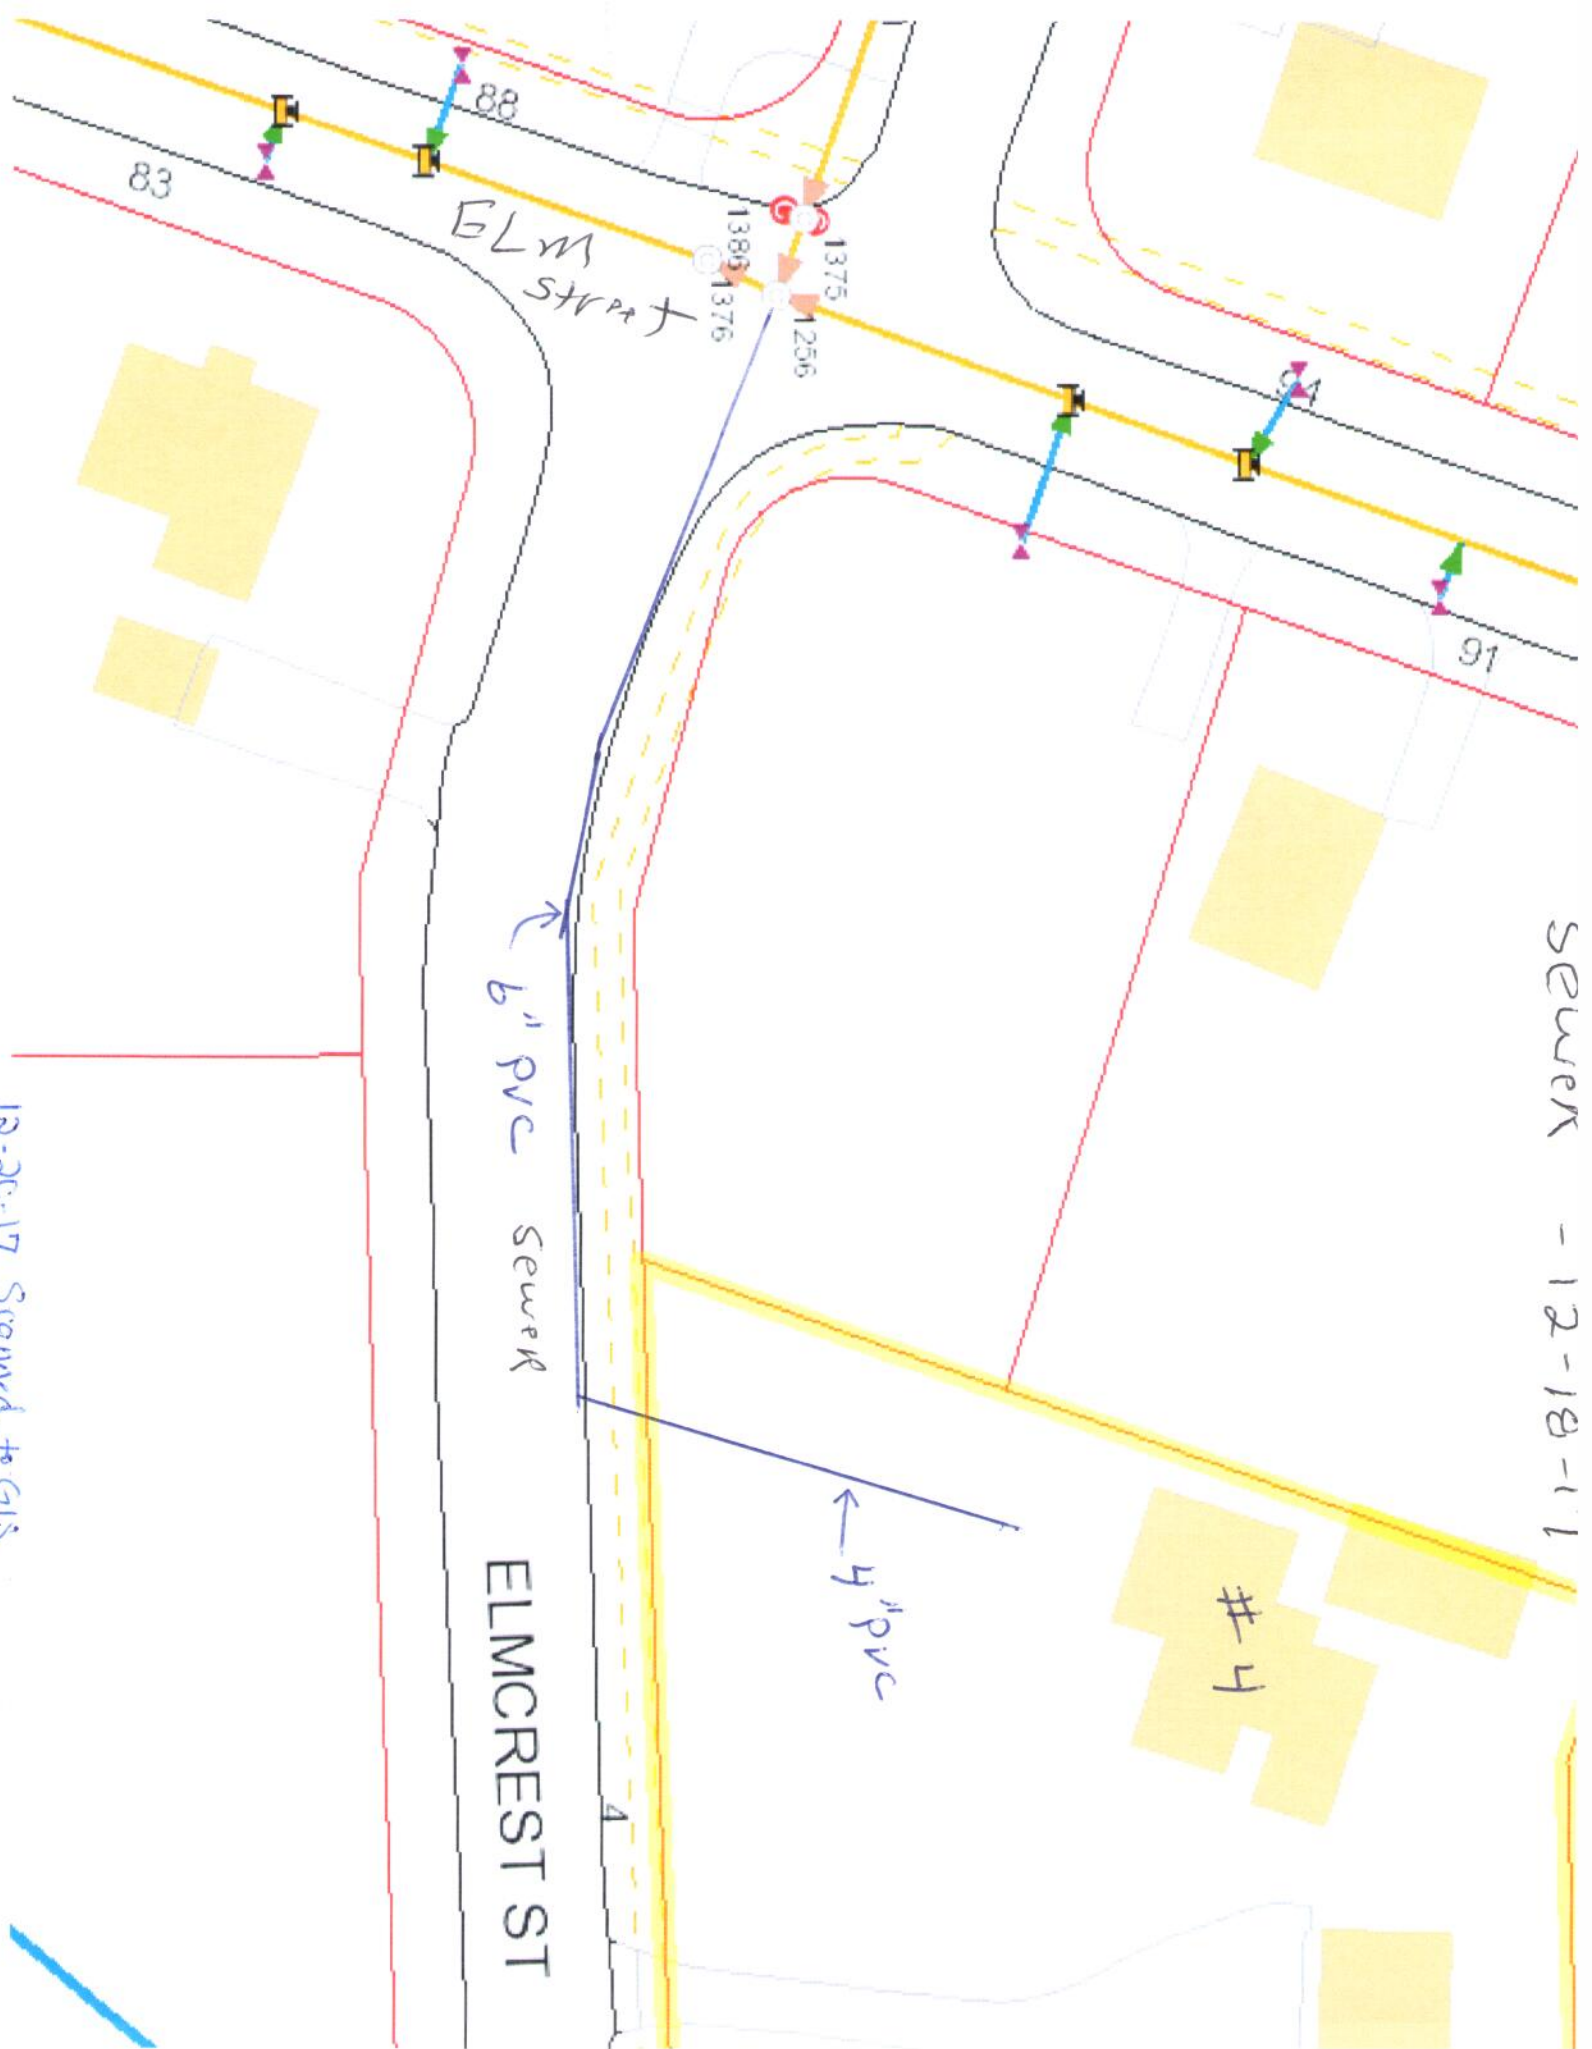

12-20-17 Scanned to GIS