




# EAST LONGMEADOW DEPARTMENT OF PUBLIC WORKS

Job: One Fairway Sewer Service  
Sheet No: 1 of 2  
Calculated By: Fois Date 7/21/20  
Scale: Feet

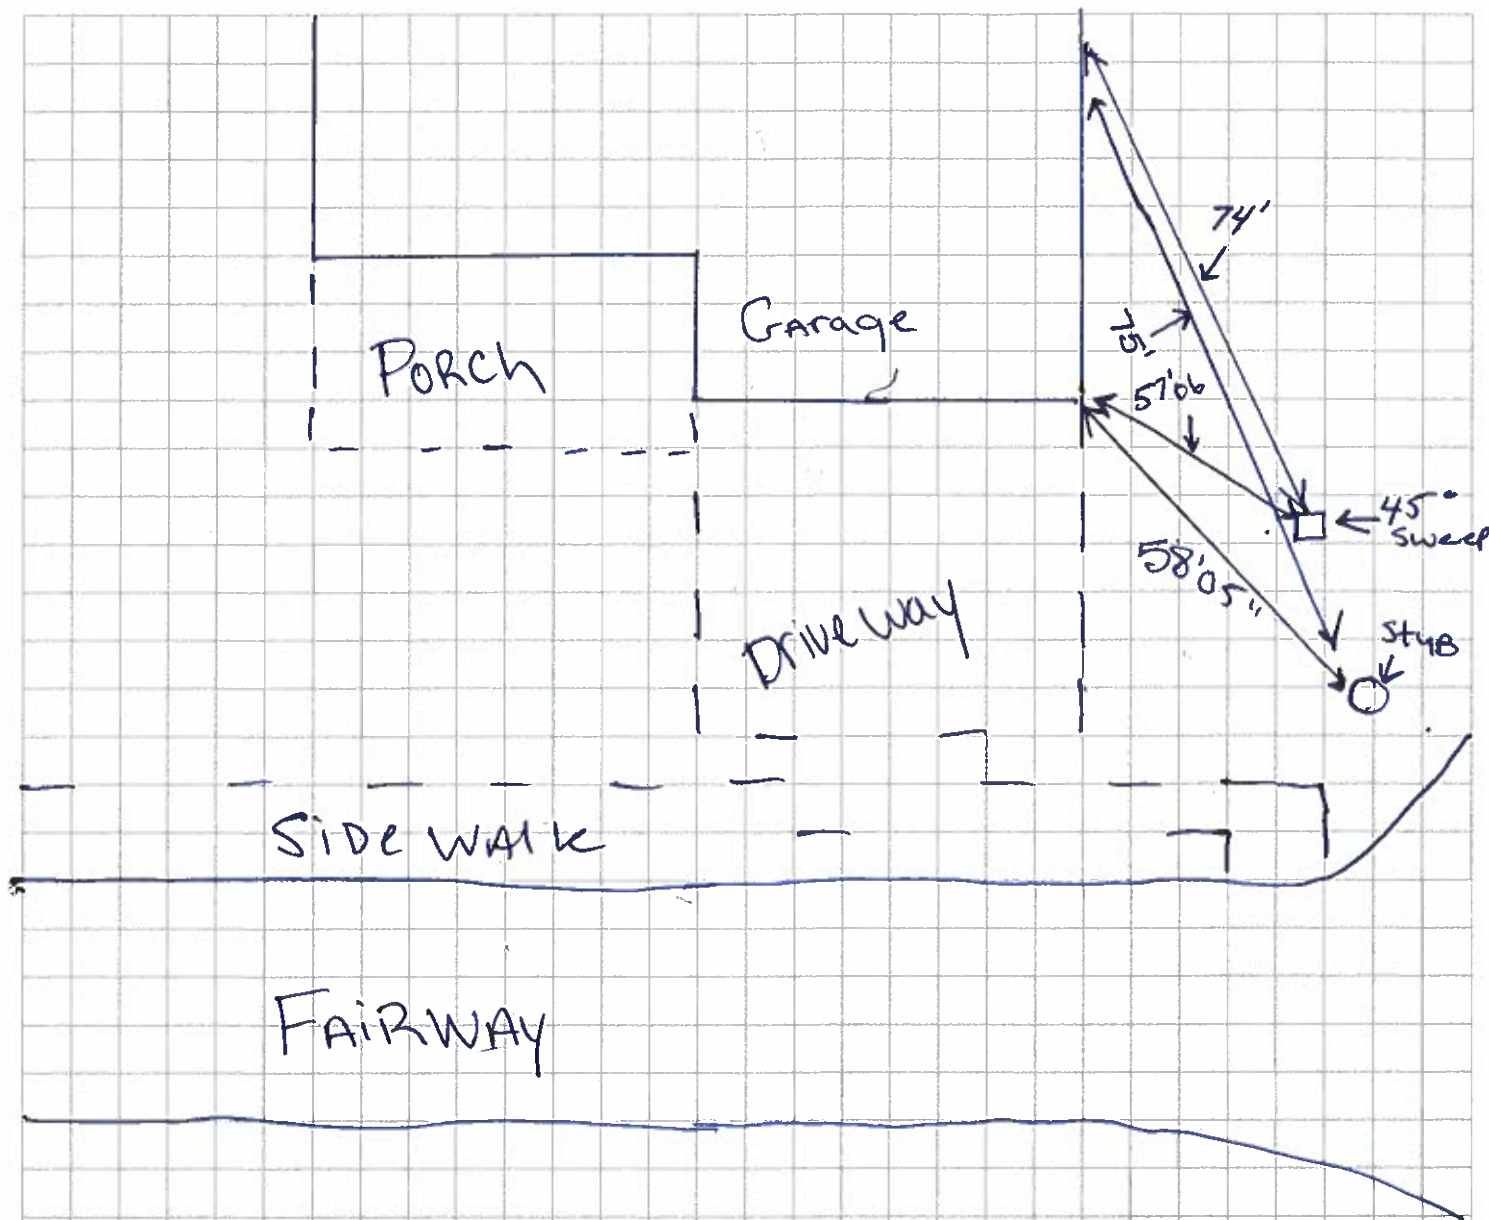

Bury Depth @ Stub 7'08