




EAST LONGMEADOW DEPARTMENT OF PUBLIC WORKS

Job: lot 2 House #3 Fairway lane (Sewer)
Sheet No: _____ of _____
Calculated By: Pope Date 1-14-21
Scale: _____

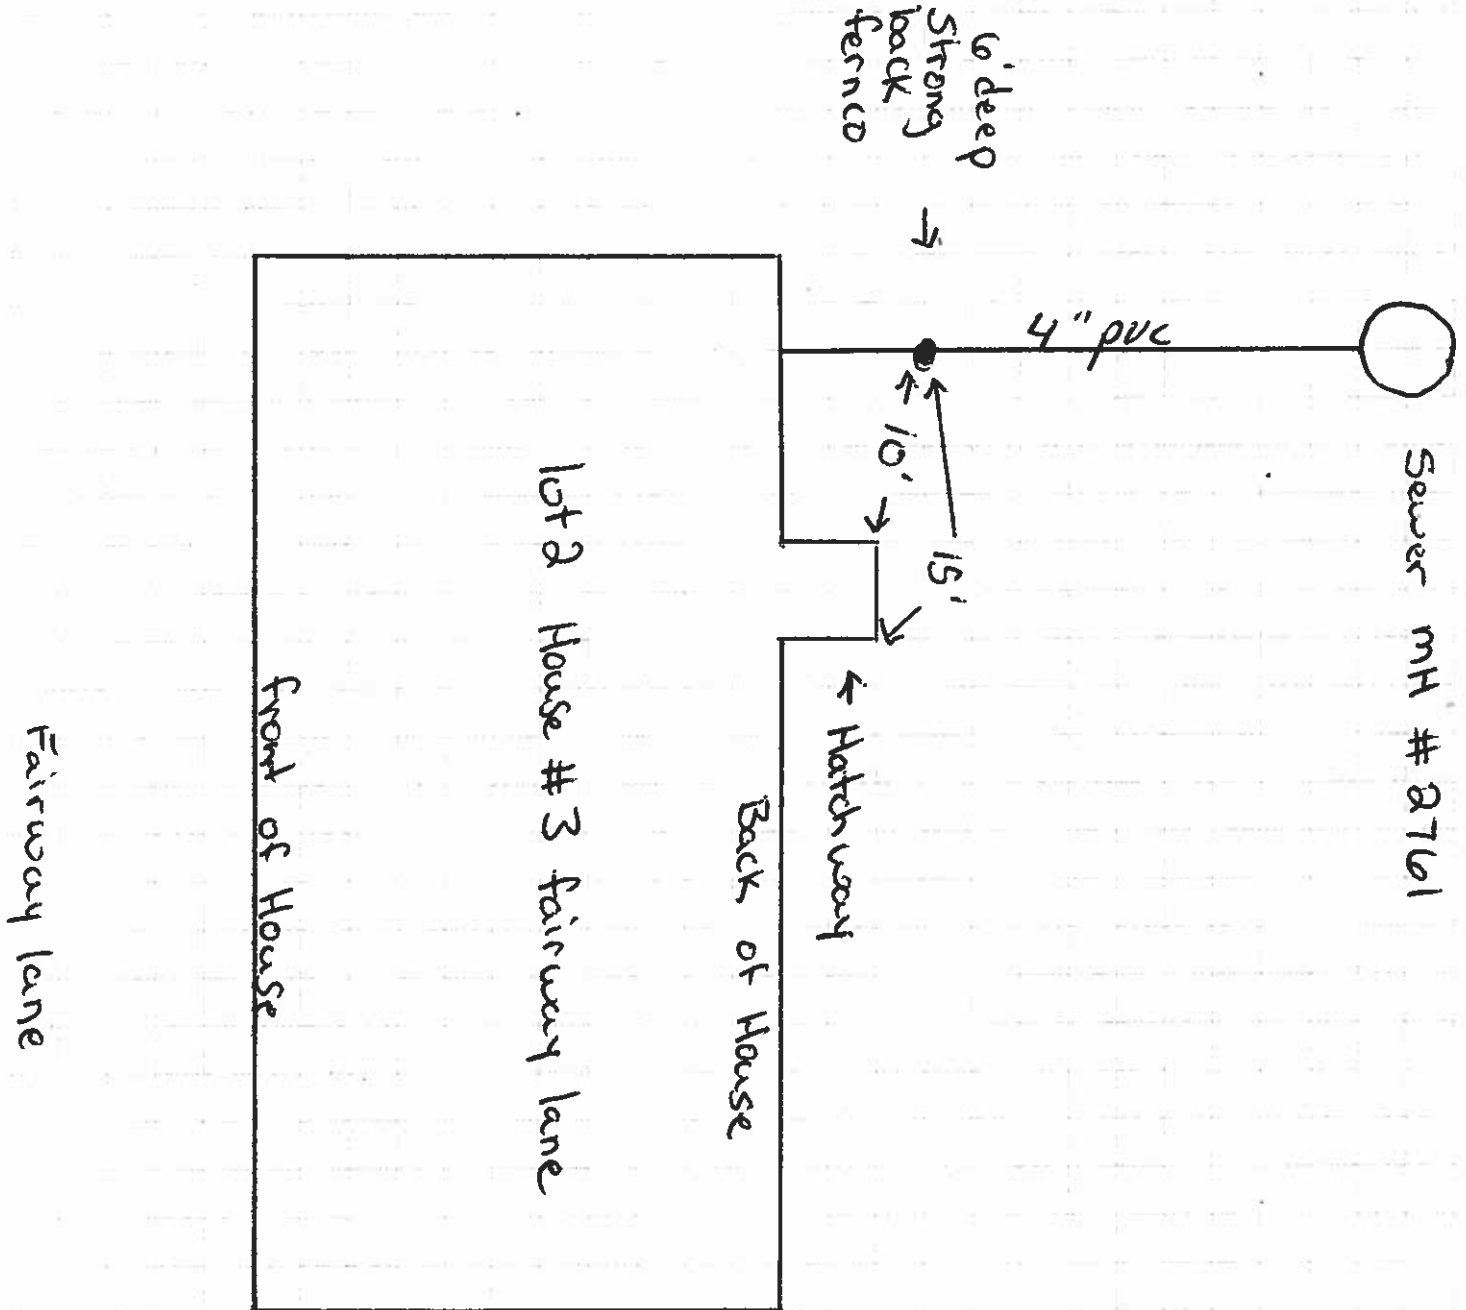

**TOWN OF EAST LONGMEADOW, MA
DEPARTMENT OF PUBLIC WORKS
SEWER INSPECTION**

DATE: 1-14-2021

Sanitary ✓

Storm _____

Other _____

Size 4" pvc

Fee \$50.00

Inspected TWP Yes

LOCATION OF PROPERTY: lot 2 House #3 Fairway lane

OWNER:

Is drain under cellar floor _____

Feet above cellar floor _____

If building has cellar or footing drains, where do they discharge:

The above fee is for the initial inspection. If initial inspection is not approved, there will be an additional fee of \$25.00 for each inspection.

It is understood that only sanitary waste is to be connected to the sanitary sewer and only clean surface or sub-surface water to storm drain.

Thomas W. Pope
DPW Inspector