


# EAST LONGMEADOW DEPARTMENT OF PUBLIC WORKS

Job: 5 Fairway lane (Sewer)  
Sheet No: Excavator - bradway of \_\_\_\_\_  
Calculated By: Pope Date 1-19-2021  
Scale: \_\_\_\_\_

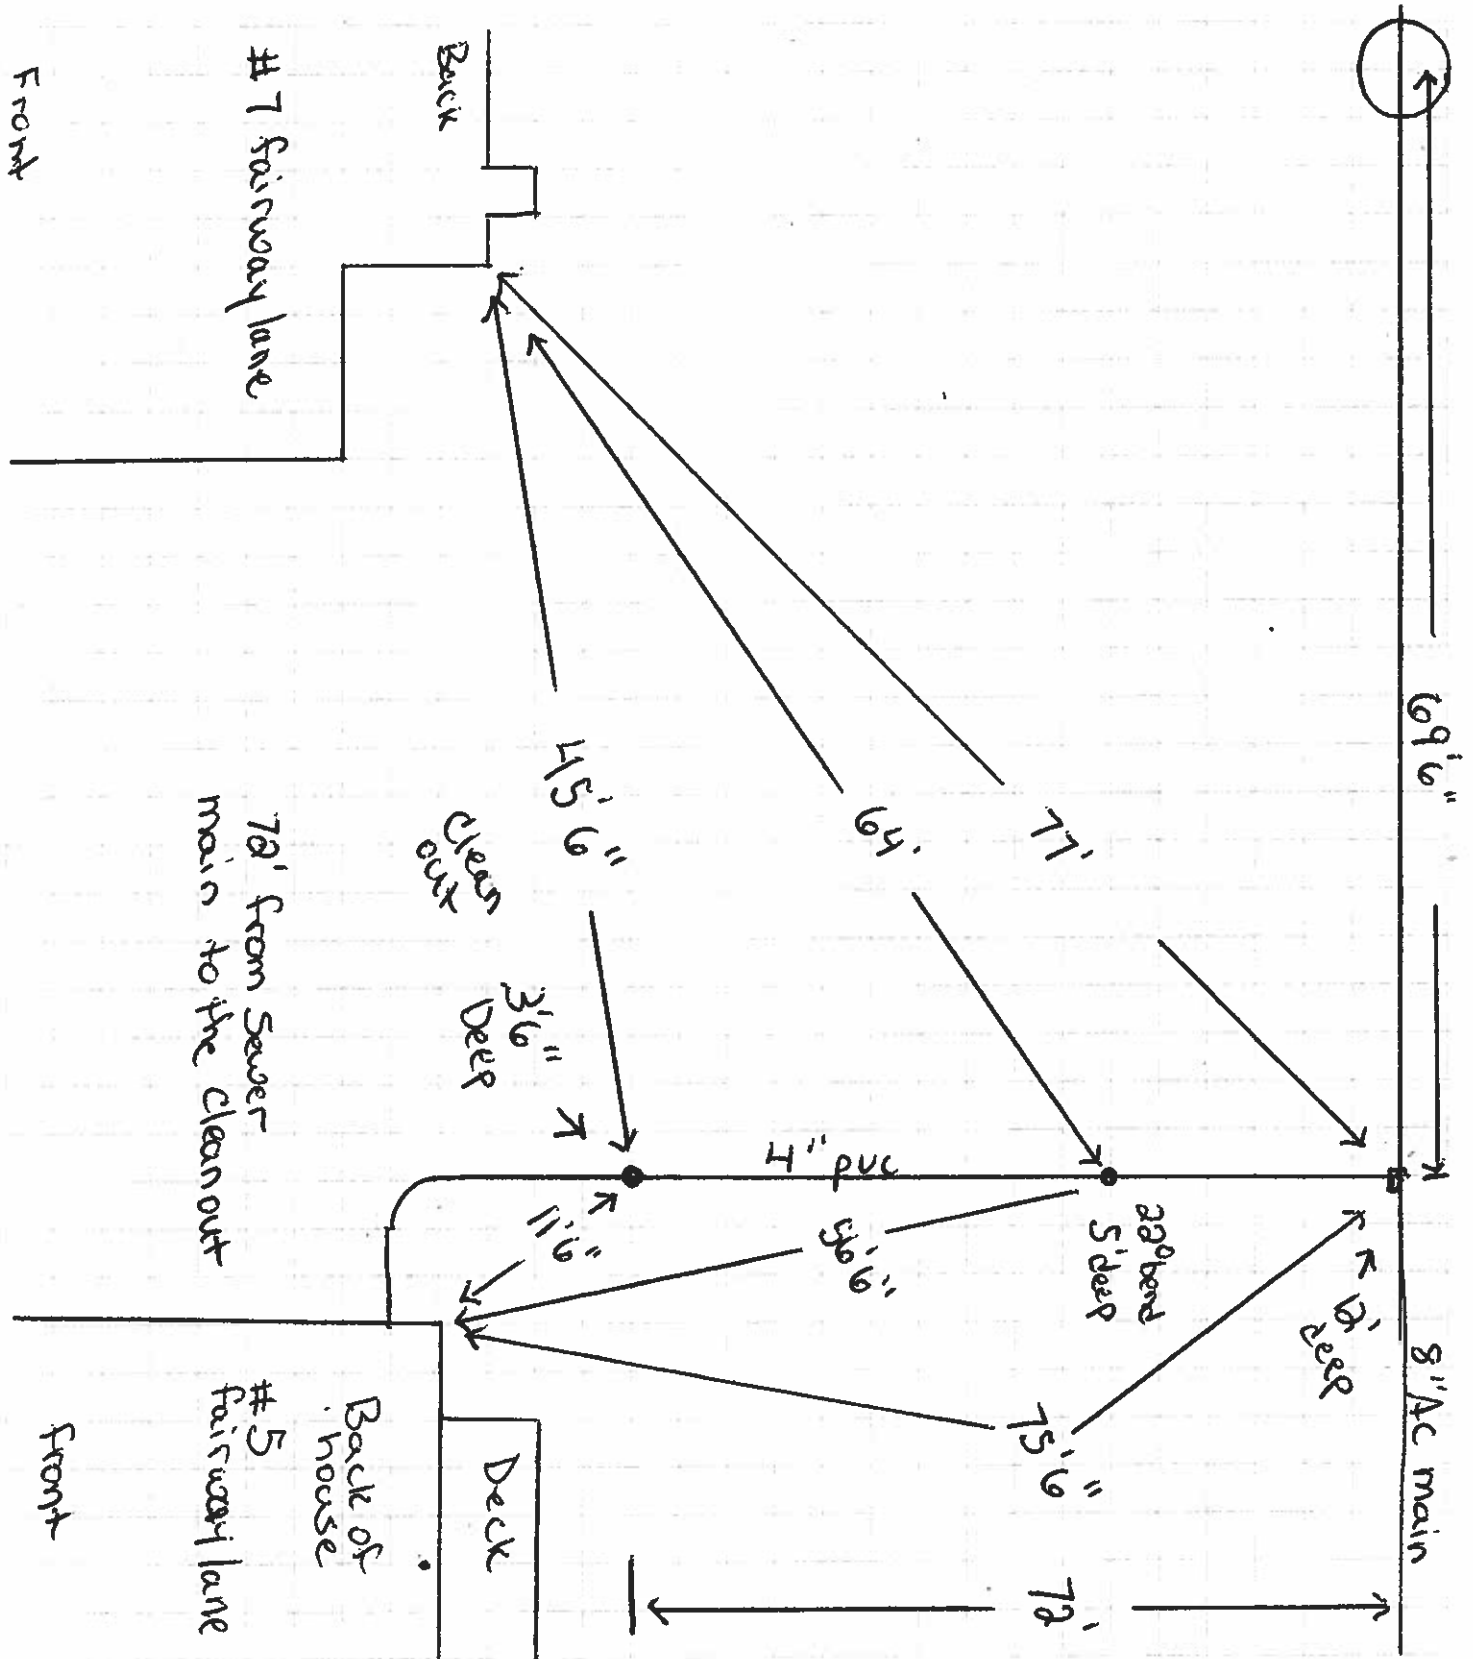

**TOWN OF EAST LONGMEADOW, MA  
DEPARTMENT OF PUBLIC WORKS  
SEWER INSPECTION**

**DATE:**

Sanitary ☒

Storm \_\_\_\_\_

Other \_\_\_\_\_

Size 4" pvc

Fee \$50.00

Inspected Yes T.W.P.

**LOCATION OF PROPERTY:** \_\_\_\_\_

**OWNER:**

Is drain under cellar floor \_\_\_\_\_

Feet above cellar floor \_\_\_\_\_

If building has cellar or footing drains, where do they discharge:

\_\_\_\_\_

The above fee is for the initial inspection. If initial inspection is not approved, there will be an additional fee of \$25.00 for each inspection.

It is understood that only sanitary waste is to be connected to the sanitary sewer and only clean surface or sub-surface water to storm drain.

Thomas H. Pope  
DPW Inspector