




EAST LONGMEADOW DEPARTMENT OF PUBLIC WORKS

Job: 10 Fairway Sewer Service
Sheet No: 1 of 1
Calculated By: Fois Date 7/22/20
Scale: Feet

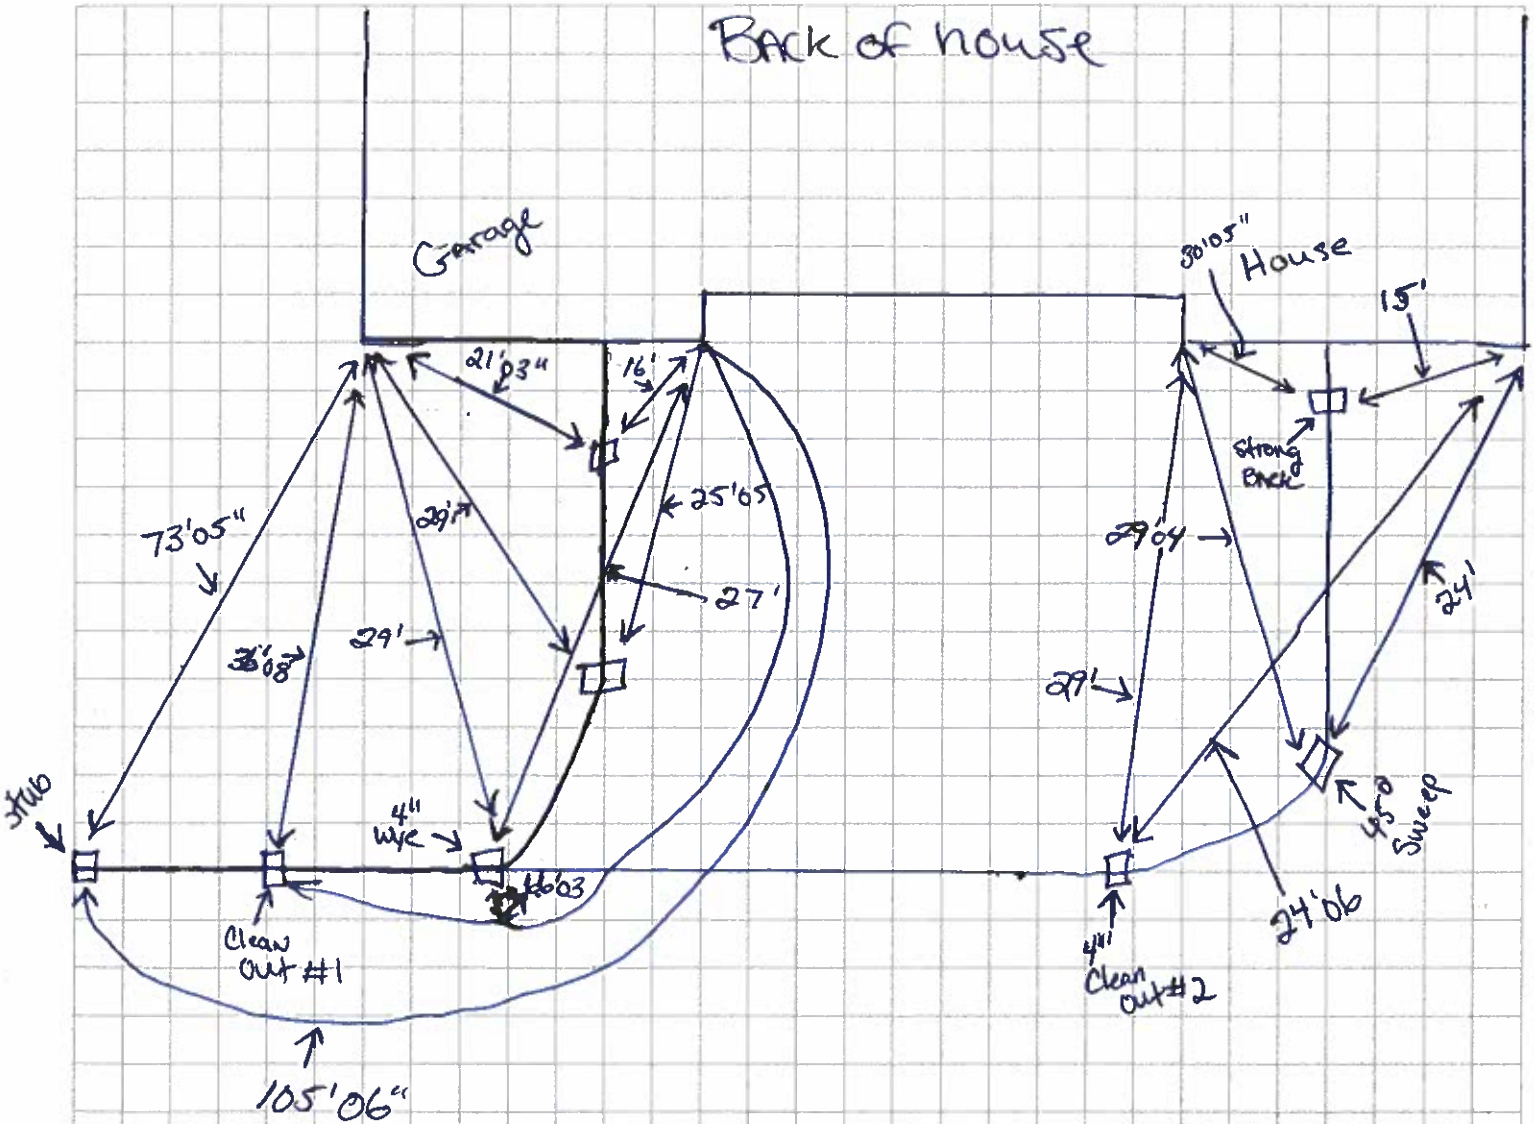

Bury depth @ Stub - 7'01
Bury depth @ Clean out #1 - 5'10"
Bury depth @ Clean out #2 - 2'08"