


EAST LONGMEADOW DEPARTMENT OF PUBLIC WORKS

Job: 12 Fairway lane (Sewer)

Sheet No: \_\_\_\_\_ of \_\_\_\_\_

Calculated By: Pope Date 12-1-2020

Scale: \_\_\_\_\_

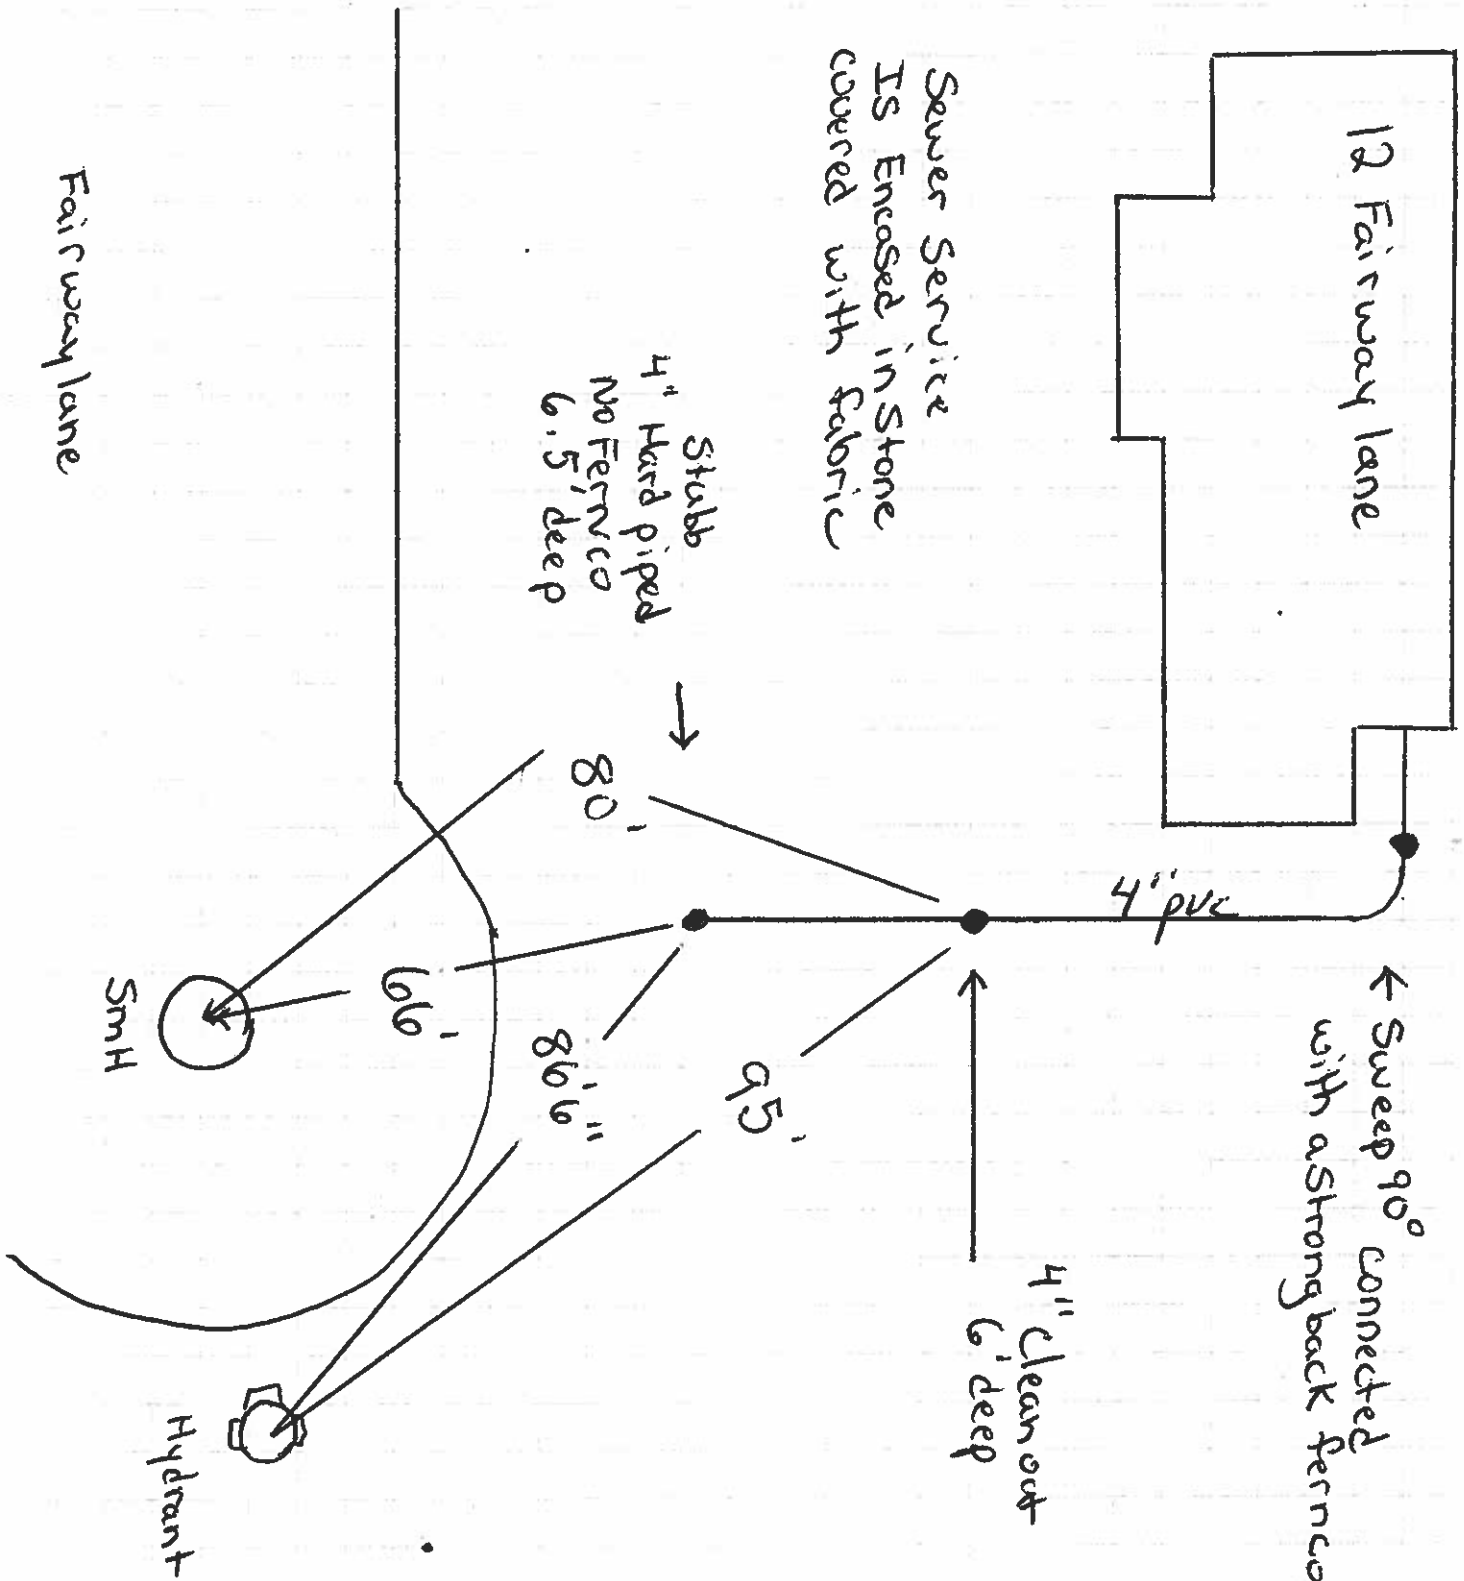

**TOWN OF EAST LONGMEADOW, MA  
DEPARTMENT OF PUBLIC WORKS  
SEWER INSPECTION**

DATE: 12-1-2020

Sanitary ✓

Storm \_\_\_\_\_

Other \_\_\_\_\_

Size 4" pvc

Fee \$50.00

Inspected YCS

LOCATION OF PROPERTY: 12 Fairway Lane

**OWNER:**

Is drain under cellar floor Yes

Feet above cellar floor 0

If building has cellar or footing drains, where do they discharge:

Sump pump out to daylight.

The above fee is for the initial inspection. If initial inspection is not approved, there will be an additional fee of \$25.00 for each inspection.

It is understood that only sanitary waste is to be connected to the sanitary sewer and only clean surface or sub-surface water to storm drain.

Thomas Pope

DPW Inspector