


No. Street Lot #16 (San Sewer)

Lot No.

67 FAVORITE LANE

Inspected

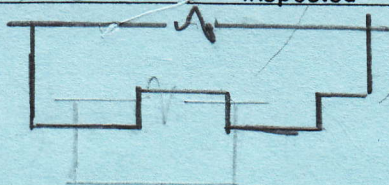

HOUSE
BUILD

