

No. Street


(San. Sewer)

Lot No.

40 FENWAY LANE

Inspected

7-11-12

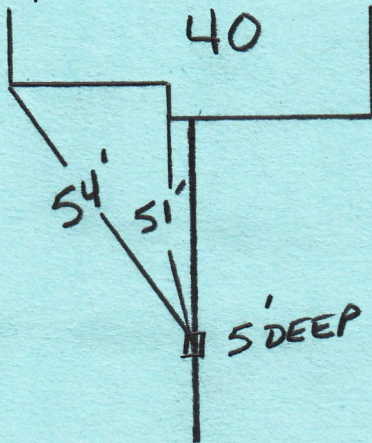

4" PVL