




EAST LONGMEADOW DEPARTMENT OF PUBLIC WORKS

Job: 88 Glen Heather (Sewer)
Sheet No: Excavator - Turnberg of _____
Calculated By: Pipe Date 4-30-21
Scale: _____

Glen Heather

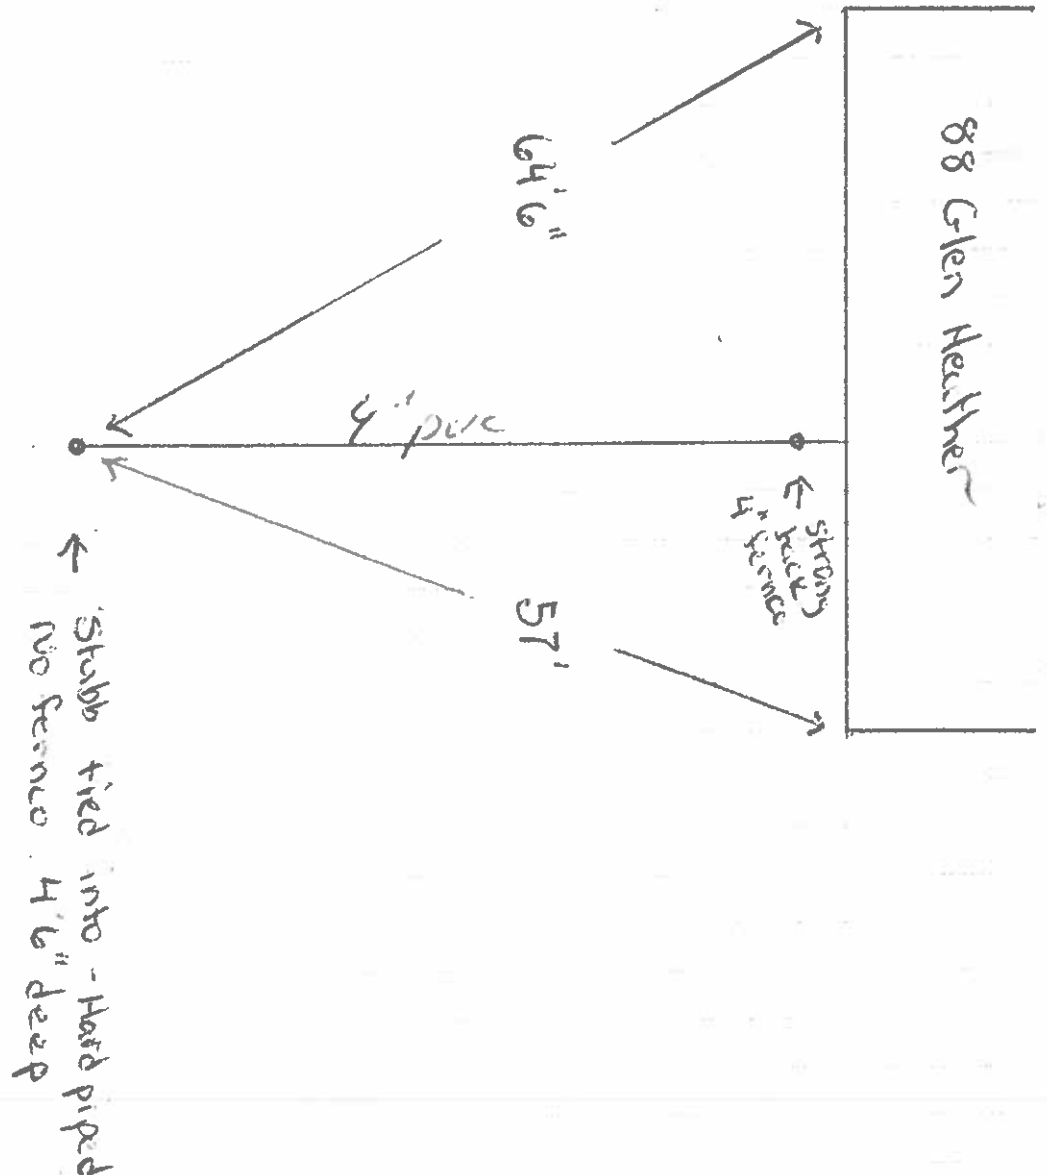

↑ Stubb tied into - Hard piped
no fence 4'6" deep

**TOWN OF EAST LONGMEADOW, MA
DEPARTMENT OF PUBLIC WORKS
SEWER INSPECTION**

DATE: 4-30-21

<u>Sanitary</u>	Storm	Other	Size 4" pvc
Fee \$50.00			Inspected Yes Pope

LOCATION OF PROPERTY: 88 Glen Heather

OWNER:

Is ^{Sewer} drain under cellar floor Yes

Feet above cellar floor

If building has cellar or footing drains, where do they discharge:

The above fee is for the initial inspection. If initial inspection is not approved, there will be an additional fee of \$25.00 for each inspection.

It is understood that only sanitary waste is to be connected to the sanitary sewer and only clean surface or sub-surface water to storm drain.

Sharon Pope
DPW Inspector