


## **EAST LONGMEADOW DEPARTMENT OF PUBLIC WORKS**

Job: 25 Granby St (Sewer Repair)

Sheet No: Excavator - Gary Turnberg or

Calculated By: Pope Date 11-1-21

Scale: \_

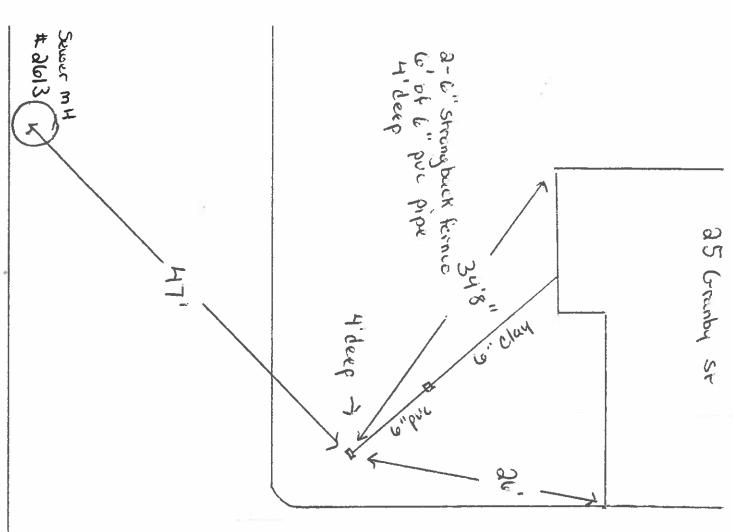

**ムアミカヘナアで** 

Granby St