




EAST LONGMEADOW DEPARTMENT OF PUBLIC WORKS

Job: 2 Hidden Ponds Dr. (Sewer)
Sheet No: Excavator - Broadway Const. of _____
Calculated By: Pope Date 4-28-21
Scale: _____

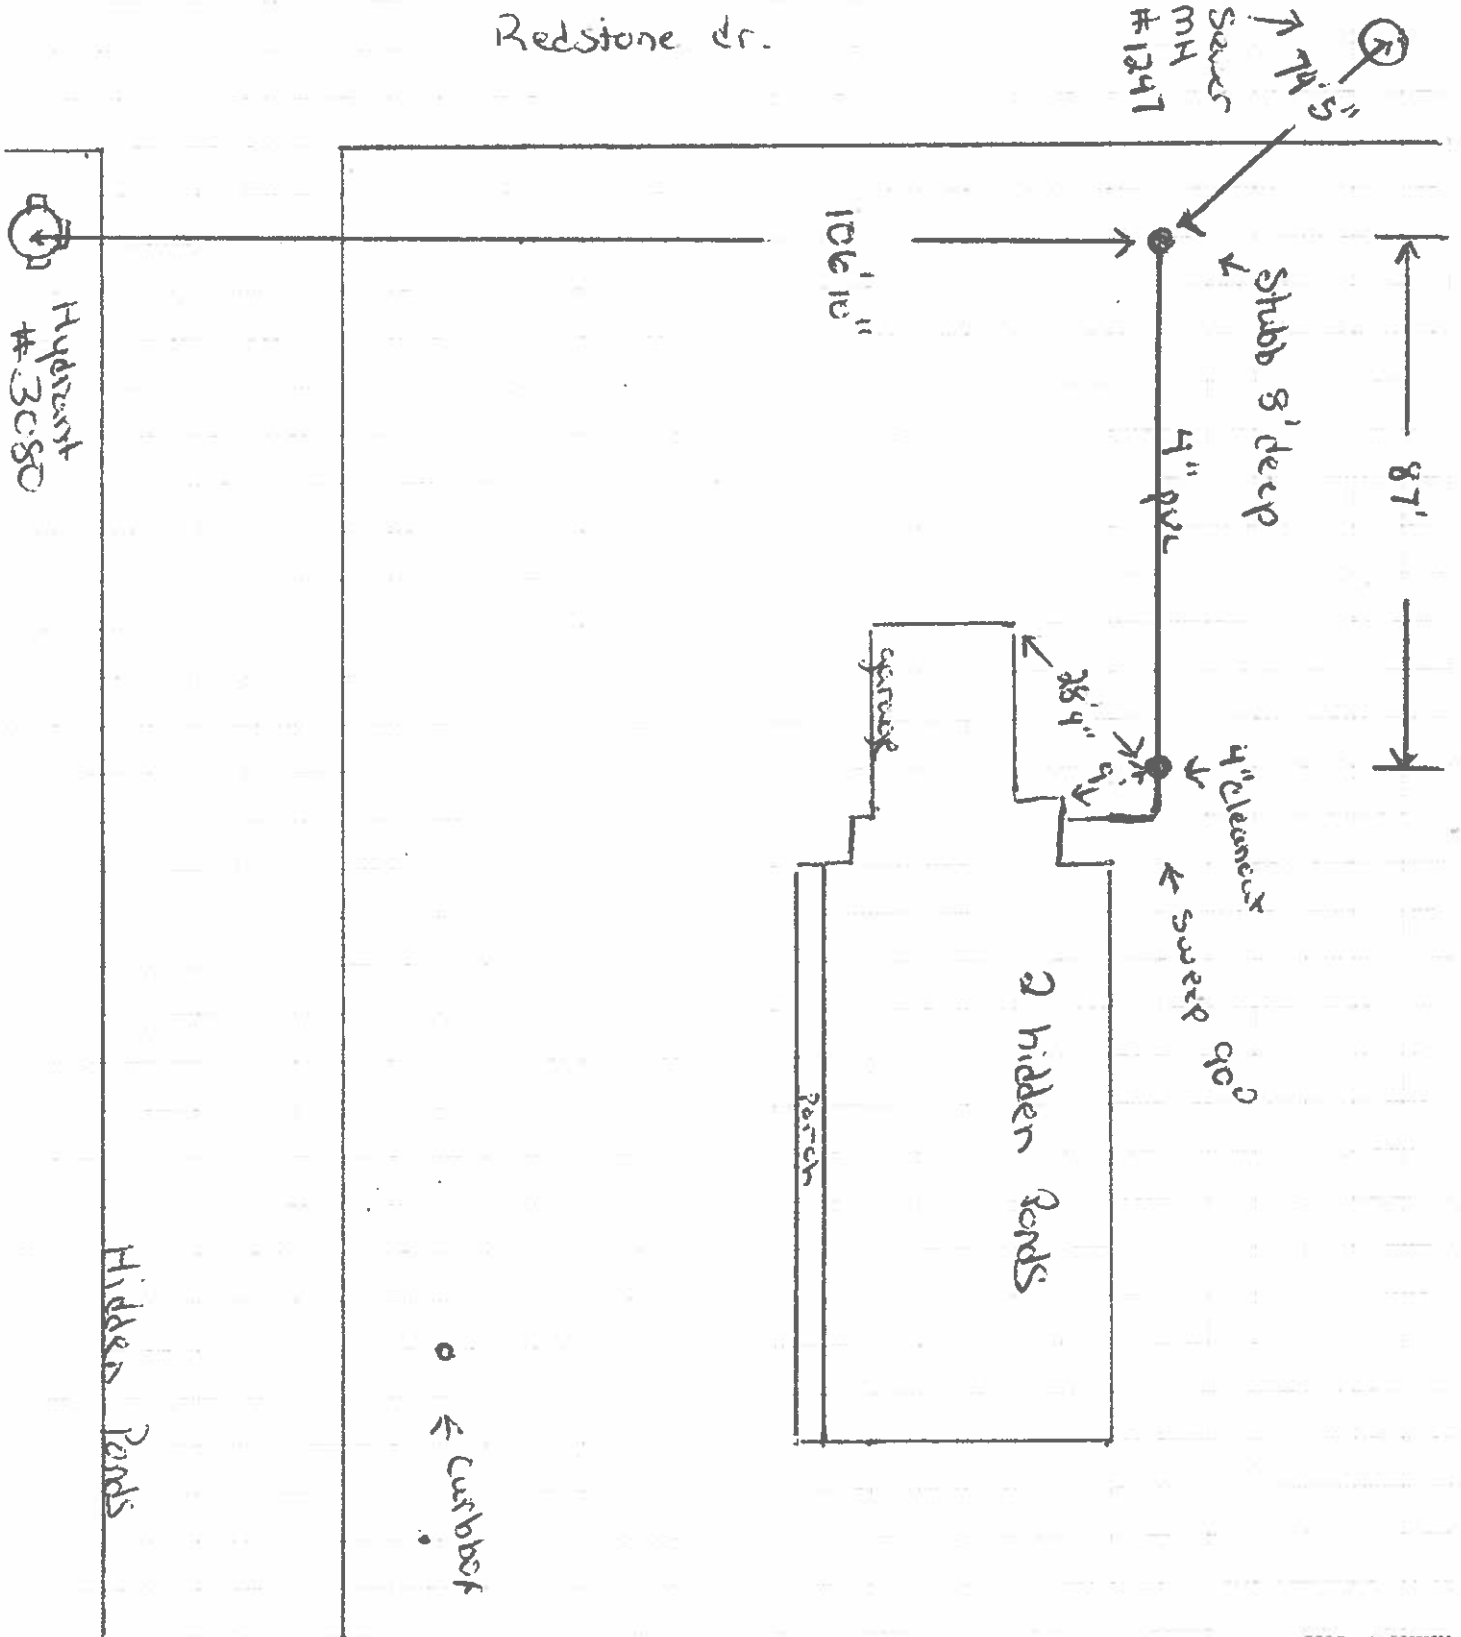

**TOWN OF EAST LONGMEADOW, MA
DEPARTMENT OF PUBLIC WORKS
SEWER INSPECTION**

DATE: 4-28-21

Sanitary

Storm

Other

Size 4" pvc

Fee \$50.00

Inspected Yes - Pope

LOCATION OF PROPERTY: 2 Hidden Ponds Drive

OWNER:

Is drain under cellar floor Sewer - through wall

Feet above cellar floor

If building has cellar or footing drains, where do they discharge:

The above fee is for the initial inspection. If initial inspection is not approved, there will be an additional fee of \$25.00 for each inspection.

It is understood that only sanitary waste is to be connected to the sanitary sewer and only clean surface or sub-surface water to storm drain.

Thomas W Pope

DPW Inspector