




# EAST LONGMEADOW DEPARTMENT OF PUBLIC WORKS

Job: 13 Hidden Ponds (Sewer)  
Sheet No: \_\_\_\_\_ of \_\_\_\_\_  
Calculated By: Pope Date 7-14-21  
Scale: \_\_\_\_\_

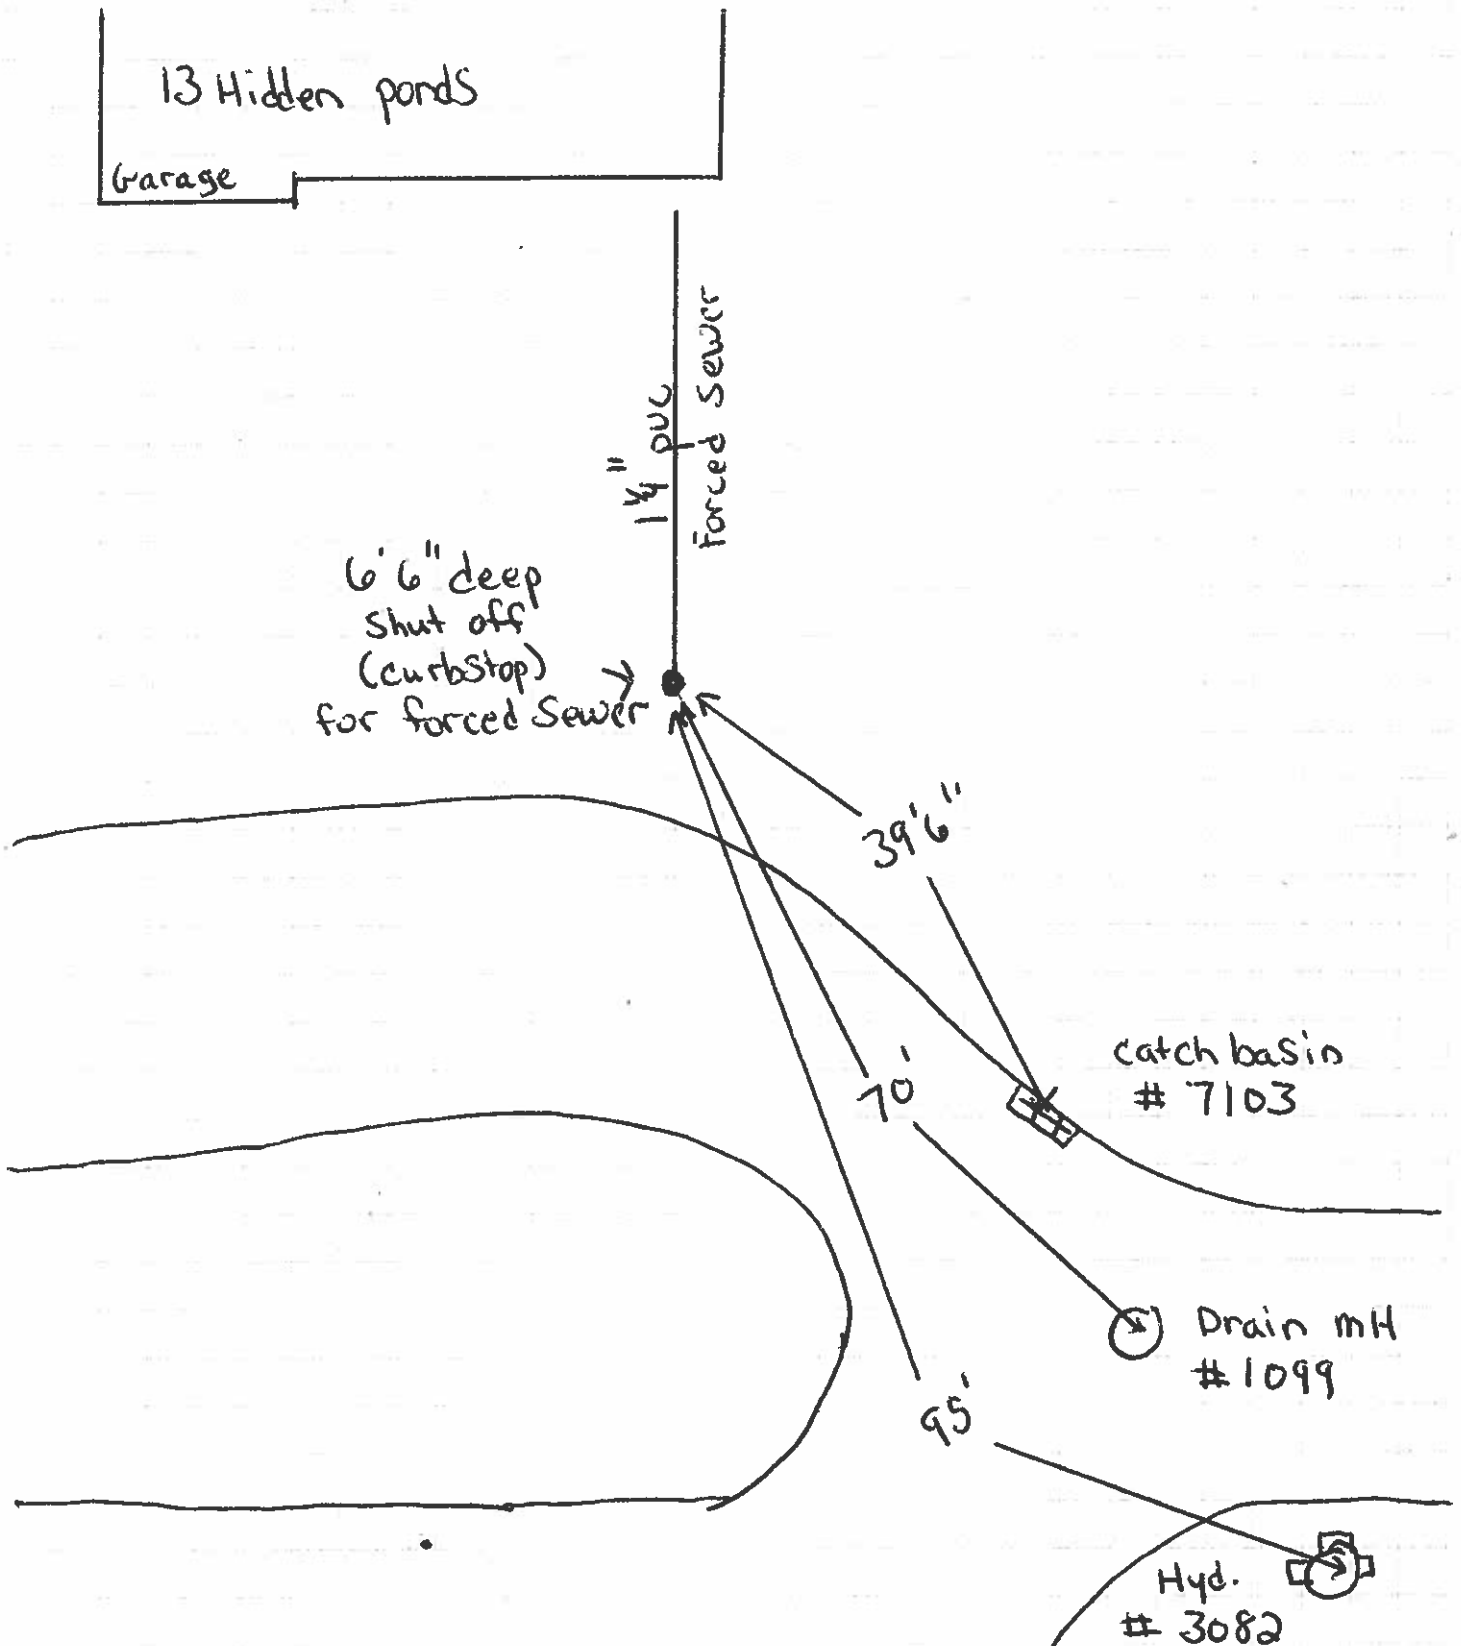

DATE: 7-14-21

Size  $1\frac{1}{4}$ " forced

Inspected Yes

**If building has cellar or footing drains, where do they discharge:**

It is understood that only sanitary waste is to be connected to the sanitary sewer and only clean surface or sub-surface water to storm drain.

Thomas L. Pope

**DPW Inspector**