




EAST LONGMEADOW DEPARTMENT OF PUBLIC WORKS

Job: 18 Hidden Ponds (Sewer)
Sheet No: Excavator - Bradley Const. of _____
Calculated By: Pope Date 5-3-21
Scale: _____

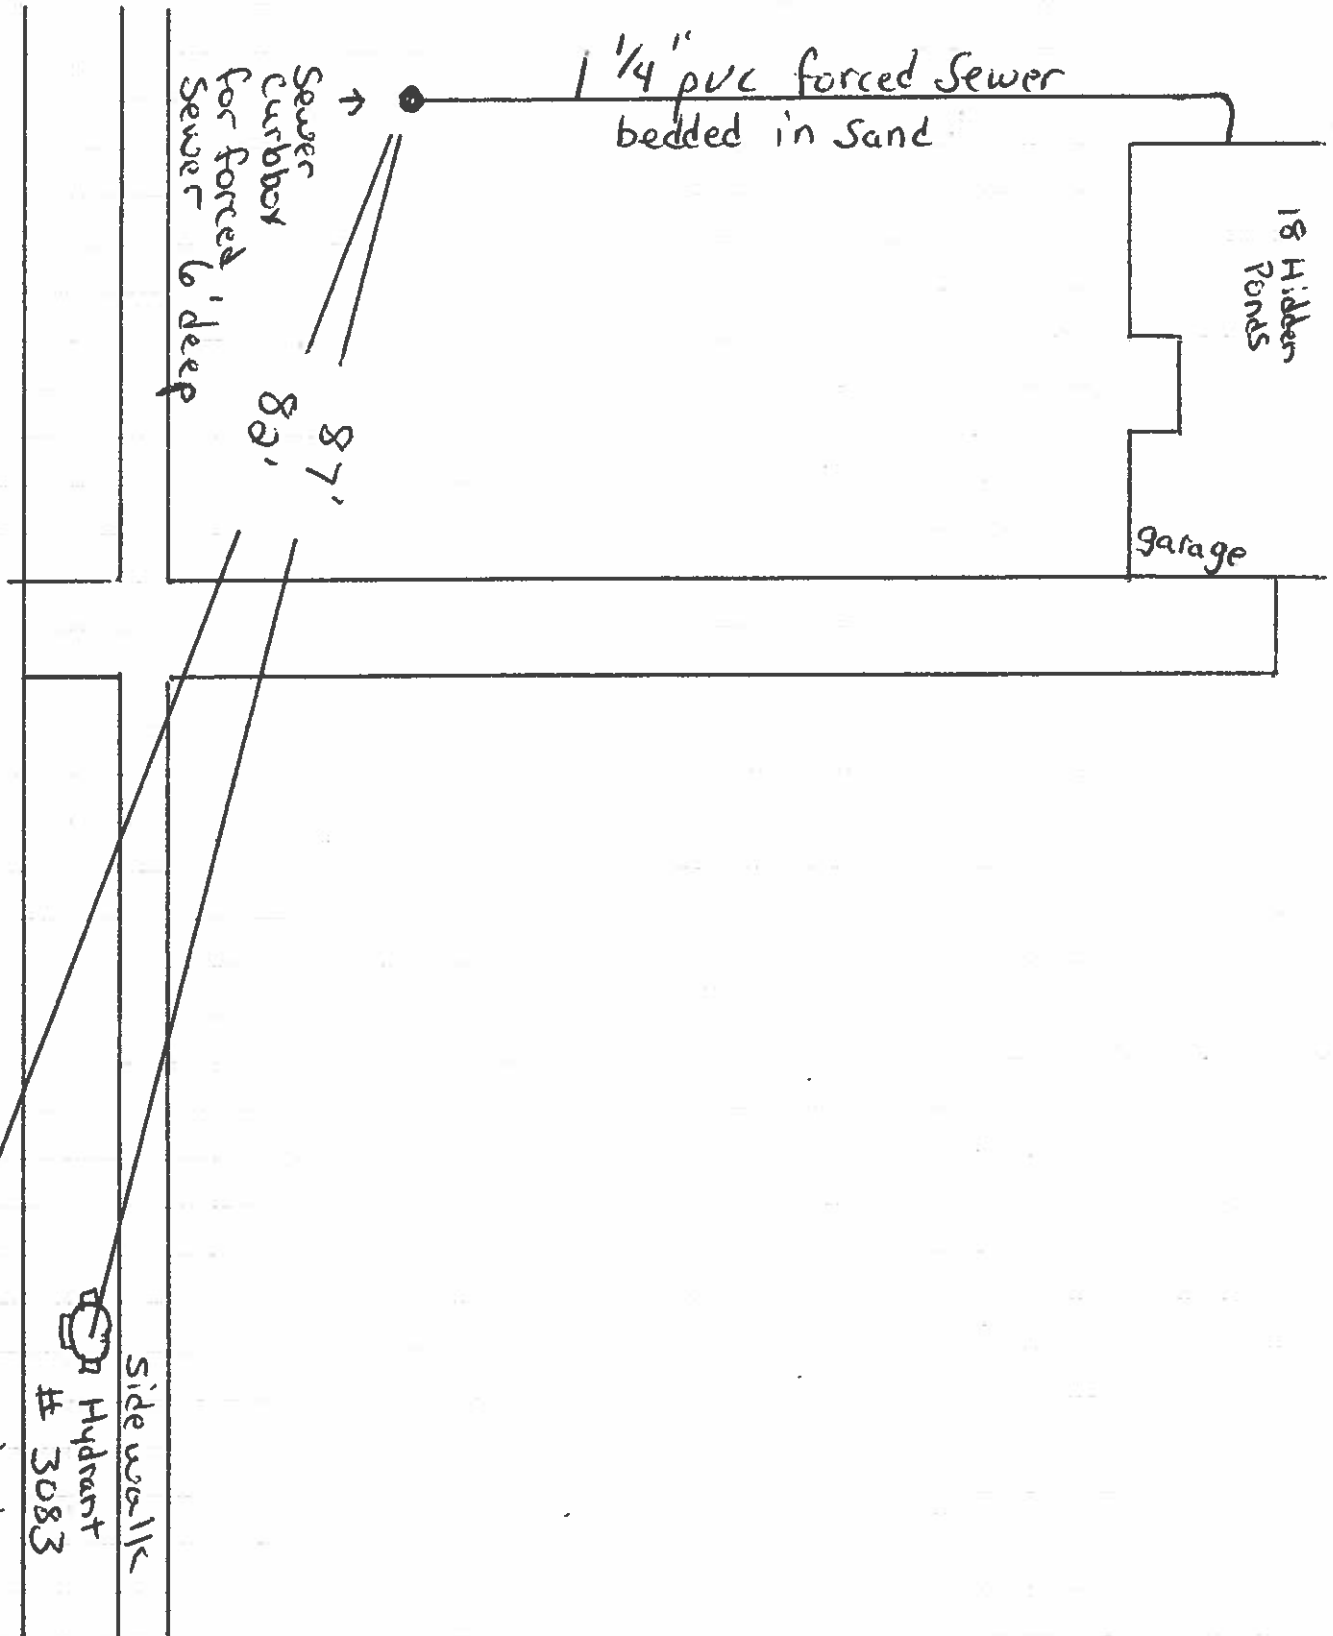

**TOWN OF EAST LONGMEADOW, MA
DEPARTMENT OF PUBLIC WORKS
SEWER INSPECTION**

DATE: 5-3-21

Sanitary

Storm

Other

Size 1 1/4" pvc
forced sewer

Fee \$50.00

Inspected Yes T. Pope

LOCATION OF PROPERTY: 18 Hidden Ponds

OWNER:


Is drain under cellar floor NO

Feet above cellar floor 2' 1 1/4" pvc forced sewer

If building has cellar or footing drains, where do they discharge:

The above fee is for the initial inspection. If initial inspection is not approved, there will be an additional fee of \$25.00 for each inspection.

It is understood that only sanitary waste is to be connected to the sanitary sewer and only clean surface or sub-surface water to storm drain.

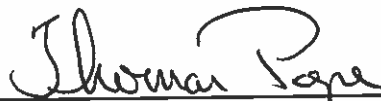

DPW Inspector