


2 EAST LONGMEADOW DEPARTMENT OF PUBLIC WORKS

Job: 2 Jeffrey Lane (Sewer)

Sheet No: Bousquet Excavation of

Calculated By: Pope Date 9-29-21

Scale: _____

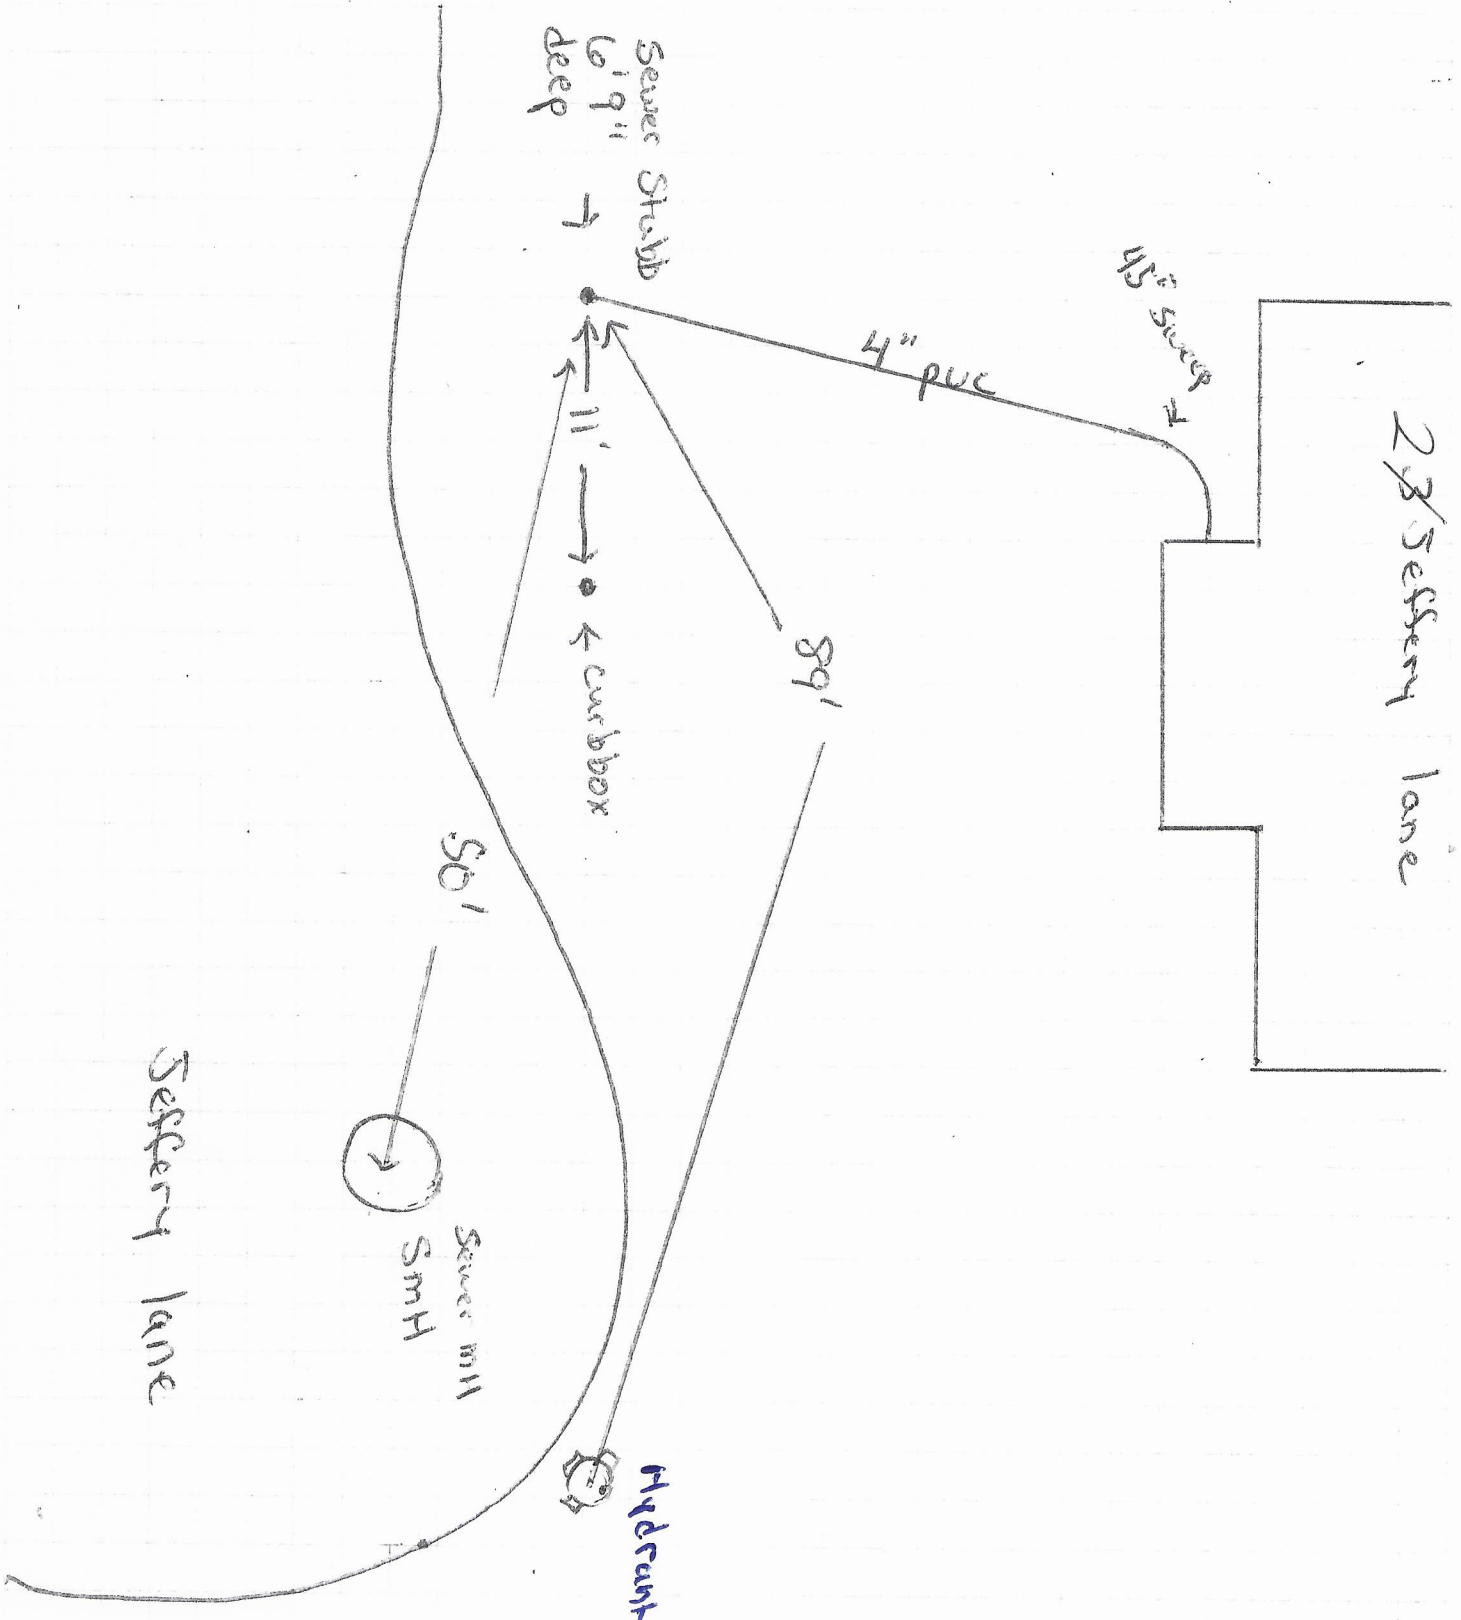

TOWN OF EAST LONGMEADOW, MA
DEPARTMENT OF PUBLIC WORKS
SEWER INSPECTION

DATE: 9-29-21

Sanitary

Storm

Other

Size 4" pvc

Fee \$50.00

Inspected Yes

LOCATION OF PROPERTY:

2
3 Jeffery Lane

OWNER:

Is drain under cellar floor

Feet above cellar floor

If building has cellar or footing drains, where do they discharge:

The above fee is for the initial inspection. If initial inspection is not approved, there will be an additional fee of \$25.00 for each inspection.

It is understood that only sanitary waste is to be connected to the sanitary sewer and only clean surface or sub-surface water to storm drain.

Shannon L. Pope

DPW Inspector