


No. Street _____ (San. Sewer) _____ Lot No. _____
235 KIBBE ROAD Inspected 10-22-13

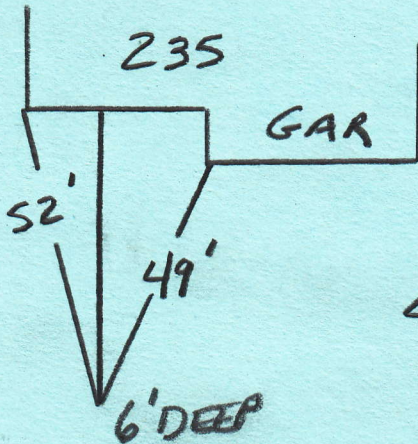

4" PVC