



EAST LONGMEADOW DEPARTMENT OF PUBLIC WORKS

Job: 290 Kibbe Rd. (Sewer)

Sheet No: Sewer Repair of _____


Calculated By: Pope Date 9-6-17

Scale: Repair Done by Gary Turnberg

290 KIBBE RD

Kibbe Rd

Repair: 2-4" strong back fence's
2-22 degree fittings 4"
4" pvc pipe

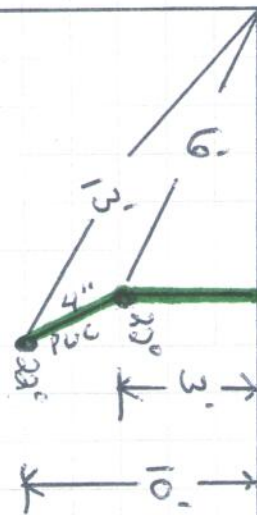

290 Kibbe Rd
Sewer Repair