




EAST LONGMEADOW DEPARTMENT OF PUBLIC WORKS

Job: Sewer Service to #38

Sheet No: Knollwood Dr. of _____

Calculated By: _____ Date 11-19-15

Scale: R/E

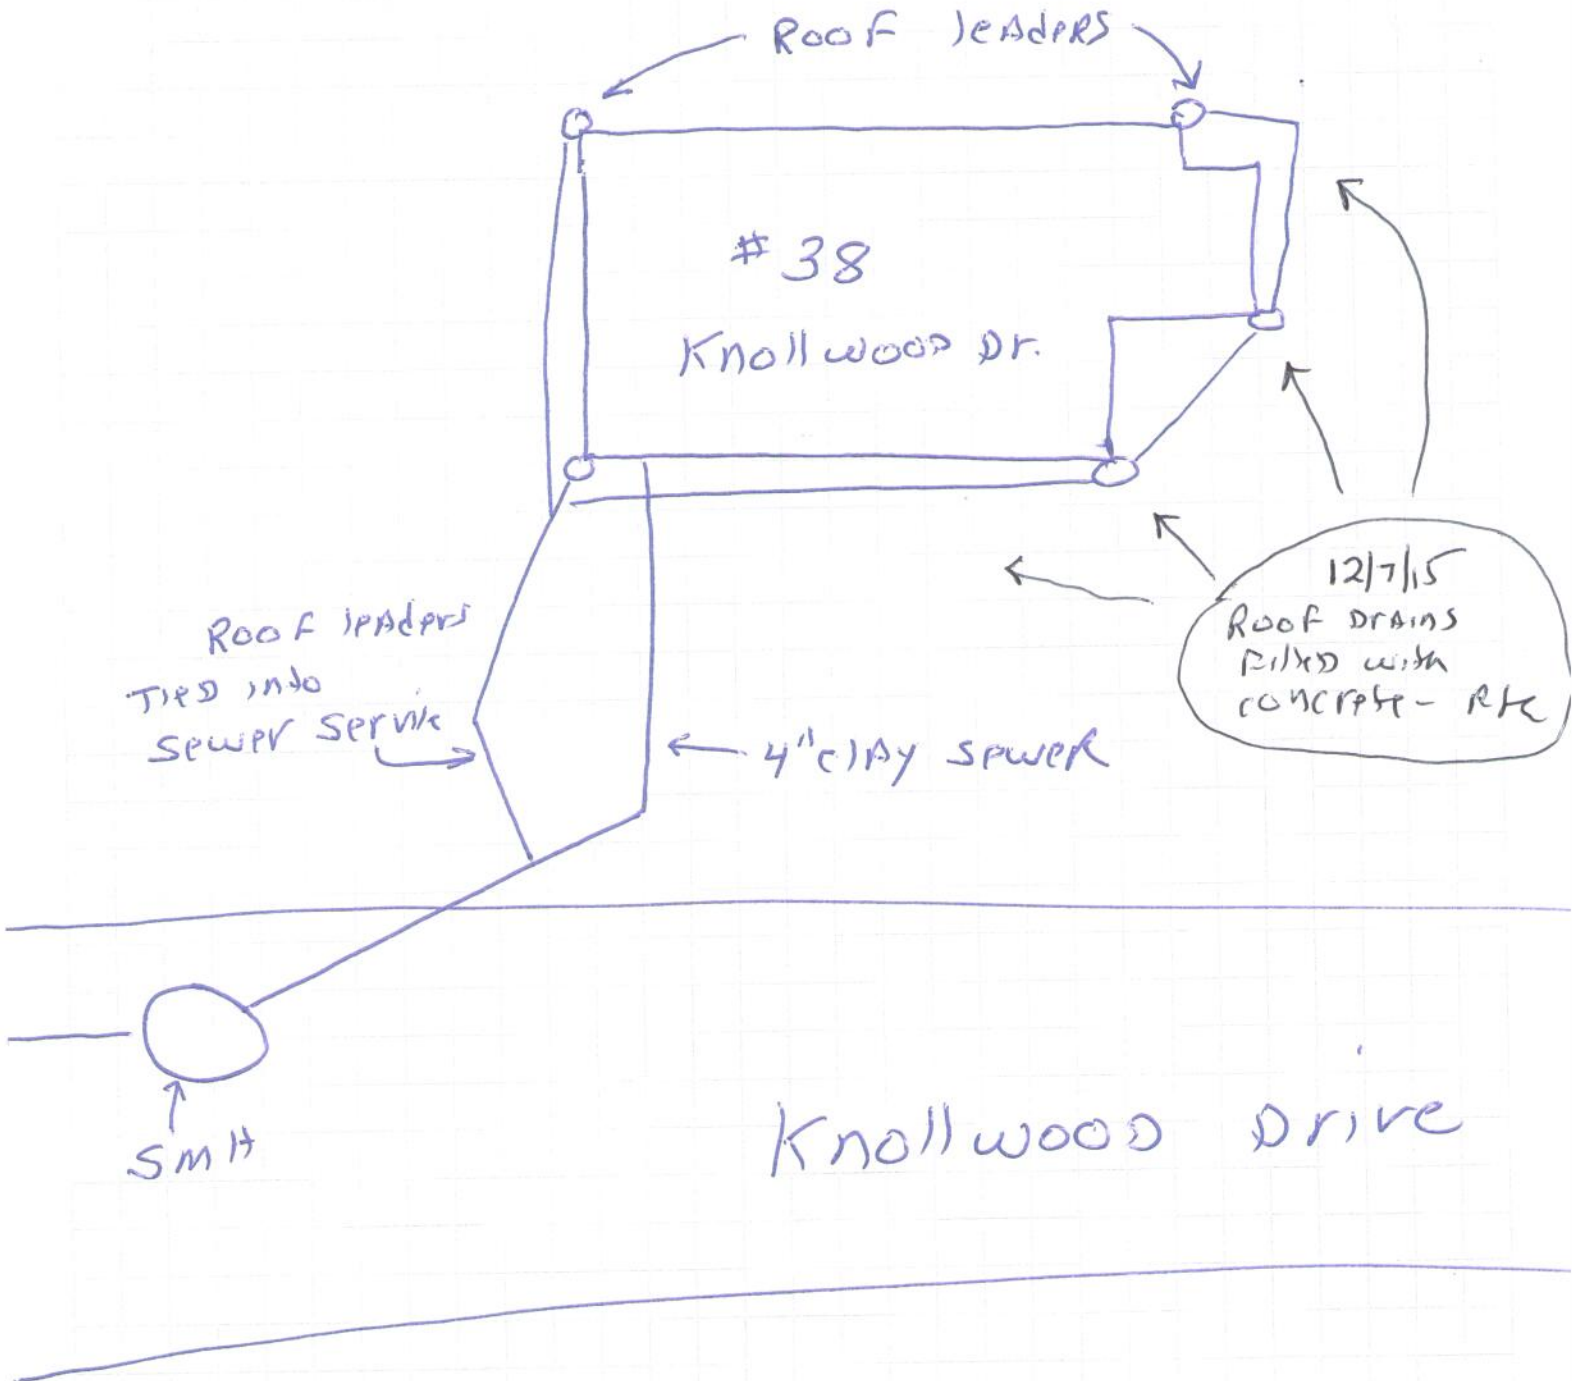



EAST LONGMEADOW DEPARTMENT OF PUBLIC WORKS

Job: Sewer Services - Knollwood Dr.

Sheet No: _____ of _____

Calculated By: RJE Date 11-19-15

Scale: _____

