

No. Street


(San. Sewer)

Lot No.

66 LEE ST

Inspected

5-19-11

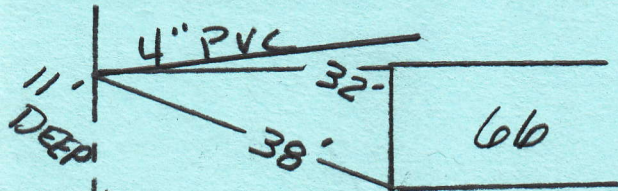

SEWER
EASEMENT

○ SMH

LEE STREET