



Sliver


EAST LONGMEADOW DEPARTMENT OF PUBLIC WORKS

Job: 28 lee St work done by Gary Turnberg

Sheet No: ~~Page - Ruel~~ of

Calculated By: pope - Ruel Date 10 - 19 - 15

Scale:

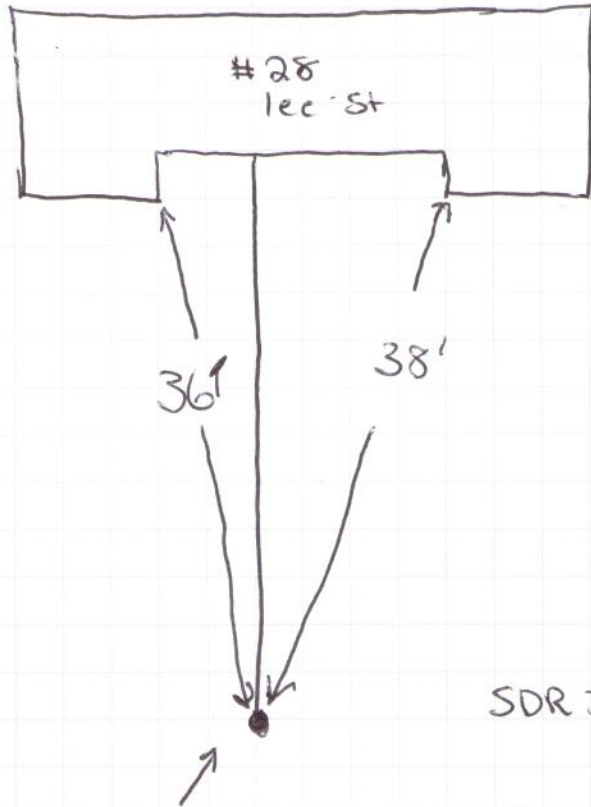

SDR 35 4" pipe

8' Deep

Hard piped
No ferro