


2/23/09

sewer connection

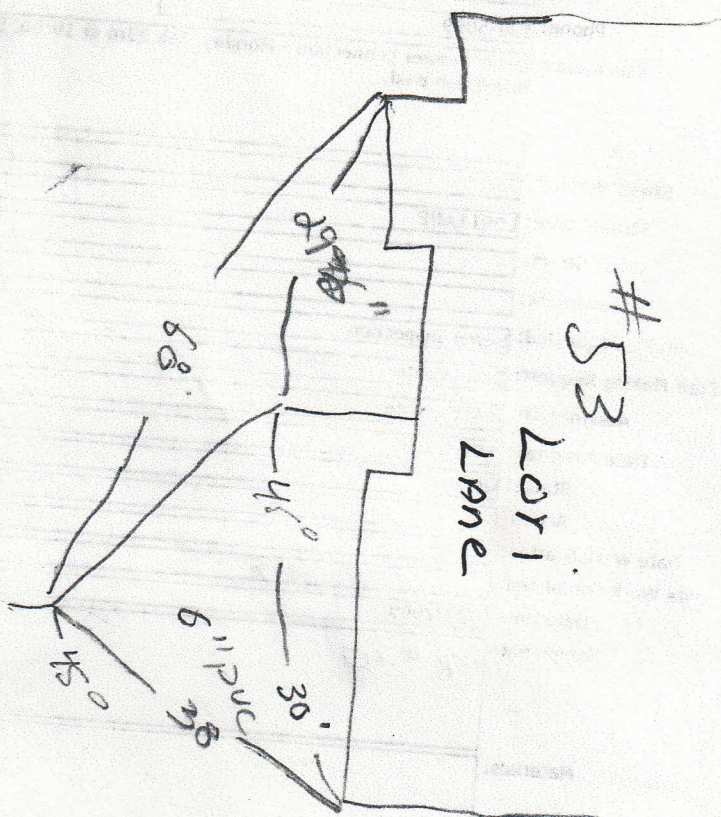

6'6" Deep